IREDELL COUNTY HEALTH DEPARTMENT

STATESVILLE 704-878-5305 MOORESVILLE 704-664-5281

IMPROVEMENT PERMIT / AUTHORIZATION TO CONSTRUCT / OPERATION PERMIT / EXISTING SYSTEM INSPECTION

PERMIT# 079316 PIN# 4893 94 8154 DATE 2-24-99

OWNER OR CONTRACTOR WILLIAM R. GIBSON, II PHONE: Business Home 876-1557

ADDRESS 2708 WILKESBORO HIGHWAY, STATESVILLE, NC 28625

LOCATION I-77 North, TL NC 901 TR UNION GROVE ROAD, 0.3 MILE ON LEFT

SUBDIVISION BLOCK / SECTION LOT LOT AREA 2.77 ACRES SITE CLASS PS DESIGN FLOW 360 L.T.A.R. 0.30 GPD/FT²

Septic Tank: 1000 Gallons; STB 1012 Date 10-23-99
Pump Tank: Gallons; PT Date
Pump Make: Model Serial No
Nitrification Field: No Fields 1 Square Feet 1200 Linear Feet 400
No Lines FOUR Trench Width 36" Max Trench Bottom Depth 30" Gravel Depth 12"

✓ New System Repair System Type: I II III IV V
System Description: CONVENTIONAL GRAVITY
Repair System Description: CONVENTIONAL GRAVITY
Maintenance Agreement Required: Yes ✓ No


✓ House/Mod. Home No. Bedrooms 3
Mobile Home No. Bathrooms 3
Business No. Employees
Other
Slab Crawl Space ✓ Basement w/plumbing Basement w/o plumbing

Water Supply: ☐ Individual ✓ Public ☐ Community


Comments/Conditions: CONSTRUCT SUBSURFACE INTERCEPT DRAINAGE DITCH AT LOCATION SHOWN BEGINNING 42" DEEP OUT TO DAYLIGHT

Comments Conditions: SEPTIC TANK WITH RISERS INSTALLED USING "POLYLOK" FILTER

INITIAL SITE SKETCH

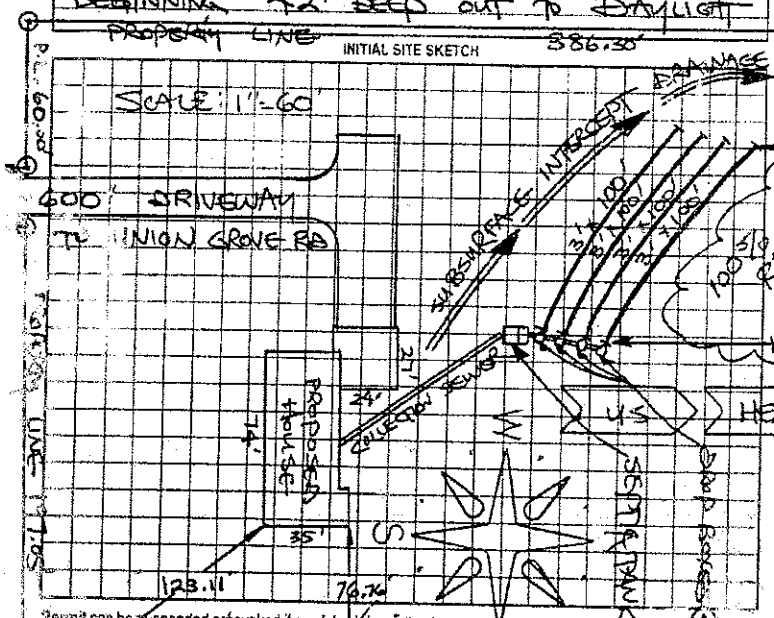

AS BUILT SKETCH

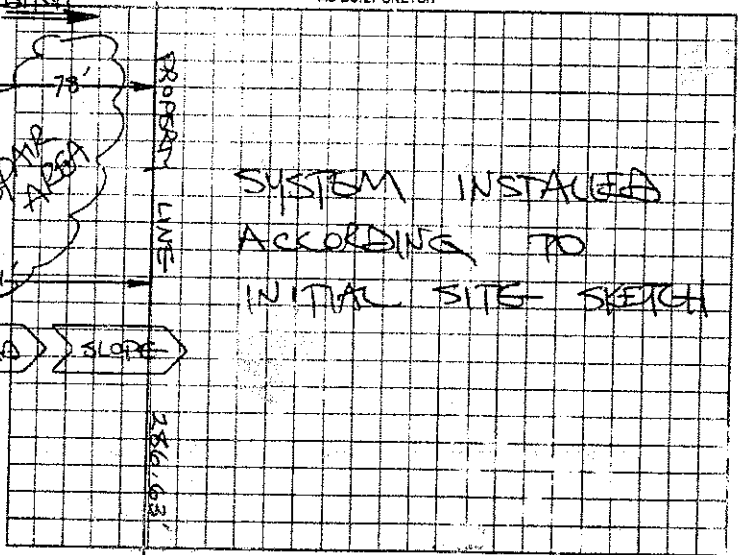

Permit can be suspended or revoked if any false information is supplied toward securing the permit; any unauthorized changes are made to the site; any unauthorized changes are made in the installation of the system. Improvement Permit will not be valid without expiration. Improvement Permit with site plan valid for sixty months. Authorization to Construct is valid for a period equal to that of Improvement Permit – not to exceed sixty months.

Signed: [signature]

Improvement Permit by: STEVE HEARICK date 2-24-99

Authorization to Construct by: STEVE HEARICK date 2-24-99

Installed by: TOMMY FRYE

Operation Permit by: STEVE HEARICK date 1-25-00

Existing System Inspection by: date

HEALTH DEPT COPY WHITE OWNER COPY (FINAL) YELLOW OWNER COPY (INITIAL) PINK