IREDELL COUNTY HEALTH DEPARTMENT

THIS PERMIT VOIDS PREVIOUS ISSUED 3-5-99

STATESVILLE 704-878-5305 MOORESVILLE 704-664-5281

IMPROVEMENT PERMIT / AUTHORIZATION TO CONSTRUCT / OPERATION PERMIT / EXISTING SYSTEM INSPECTION

PERMIT# 079325 PIN# 4844 00 0630 DATE 11-20-00

OWNER OR CONTRACTOR ANDREW HARRIS PHONE: Business Home (704) 546-2293

ADDRESS 242-A TOMLYN ROAD, HARMONY, NC 28634

LOCATION I-77N, TL NC 901N, TR WARREN BRIDGE, TL BUTCH BRANCH, 0.5 MILE ON LEFT

SUBDIVISION BLOCK / SECTION LOT LOT AREA 16.50 ACRES SITE CLASS PS DESIGN FLOW 240 L.T.A.R. 0.30 GPD/FT²

Septic Tank: 1000 Gallons; STB 1012 Date 9/25/00
Pump Tank: Gallons; PT Date
Pump Make: Model Serial No.
Nitrification Field: No Fields 1 Square Feet 810 Linear Feet 270
No Lines THREE Trench Width 36" Max Trench Bottom Depth 36" Gravel Depth 12"

✓ New System ☐ Repair System Type I II III IV V VI
System Description: CONVENTIONAL GRAVITY
Repair System Description: CONV. GRAVITY
Maintenance Agreement Required: ☐ Yes ✓ No
☐ Slab ✓ Crawl Space ☐ Basement w/plumbing ☐ Basement wo/plumbing


✓ House/Mod. Home No. Bedrooms 2
☐ Mobile Home No. Bathrooms 1
☐ Business No. Employees
☐ Other

Water Supply: ✓ Individual ☐ Public ☐ Community
WELL


Comments/Conditions

Comments/Conditions POLYLOK FILTER INSTALLED

INITIAL SITE SKETCH SCALE: 1" = 30'

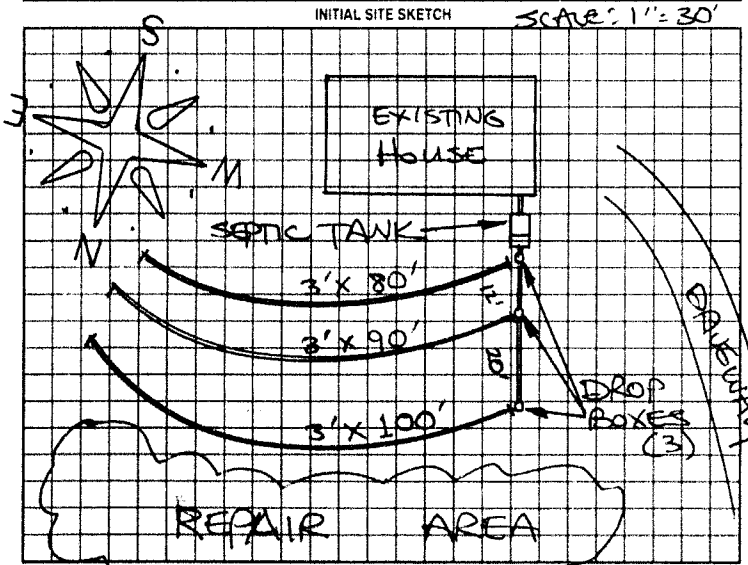

AS BUILT SKETCH

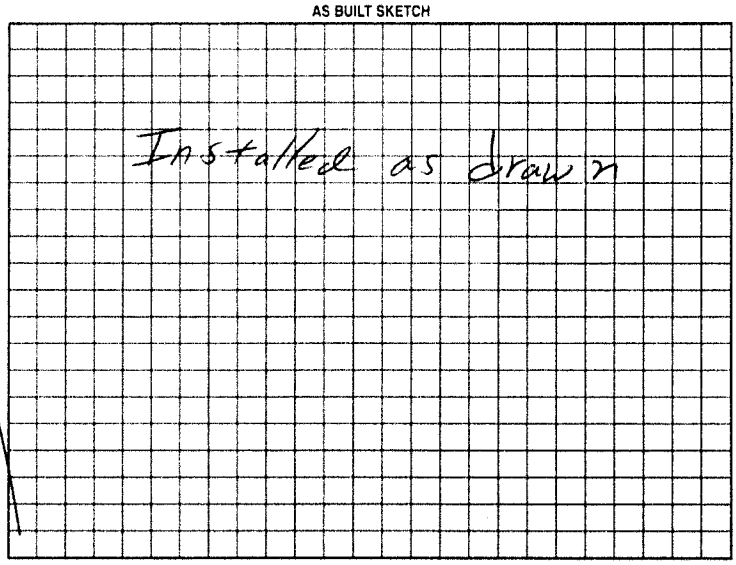

Permit can be suspended or revoked if any false information is supplied toward securing the permit; any unauthorized changes are made to the site; any unauthorized changes are made in the installation of the system. Improvement Permit with plat valid without expiration. Improvement Permit with site plan valid for sixty months. Authorization to Construct is valid for a period equal to that of Improvement Permit - not to exceed sixty months.

Signed: [signature] date 11-20-00 Installed by: JEFF HUNTLEY

Improvement Permit by: STEVE HEDRICK date 11-20-00 Operation Permit by: William Johnson REI date 1-11-01

Authorization to Construct by: STEVE HEDRICK date 11-20-00 Existing System Inspection by: date

HEALTH DEPT COPY WHITE OWNER COPY (FINAL) YELLOW OWNER COPY (INITIAL) PINK