IREDELL COUNTY HEALTH DEPARTMENT

STATESVILLE 704-878-5305 MOORESVILLE 704-664-5281

IMPROVEMENT PERMIT / AUTHORIZATION TO CONSTRUCT / OPERATION PERMIT / EXISTING SYSTEM INSPECTION

PERMIT# 128625 PIN# 4844-01-8348 DATE 7-22-05

OWNER OR CONTRACTOR ALLEN TATE REALTY- BRENDA JORDAN PHONE: Business (704)450-3076 Home

ADDRESS 134-I TOWN CENTER DRIVE MOORESVILLE NC 28117

LOCATION I-77N TL HWY 901 TR WARREN BRIDGE RD TL BUTCH BRANCH RD PROPERTY ON RIGHT

SUBDIVISION BLOCK / SECTION LOT LOT AREA 9.804 SITE CLASS PS DESIGN FLOW 480 L.T.A.R. 0.30 GPD/FT2

Septic Tank: 1000 Gallons: STB 1012 Date 6-11-07
Pump Tank: Gallons; PT Date
Pump Make: Model Serial No.
Nitrification Field: No. Fields 1 Square Feet 1600 Linear Feet 400
No Lines FOUR(4) Trench Width 36" Max Trench Bottom Depth 30" Gravel Depth N/A

☑ New System ☐ Repair System Type: I (II) III IV V VI
System Description: GRAVITY, 25% REDUCTION
Repair System Description: SAME
Maintenance Agreement Required: ☐ Yes ☑ No
☐ Slab ☑ Crawl Space ☐ Basement w/plumbing ☐ Basement wo/plumbing


☑ House/Mod. Home ☐ Mobile Home ☐ Business ☐ Other
No. Bedrooms 3 No. Bathrooms No. Employees

Water Supply: ☑ Individual ☐ Public ☐ Community


Comments:/Conditions: (1) INSTALL SYSTEM ON CONTOUR
(2) MAINTAIN ALL SETBACKS

Comments:/Conditions: Yellow Fitty

INITIAL SITE SKETCH

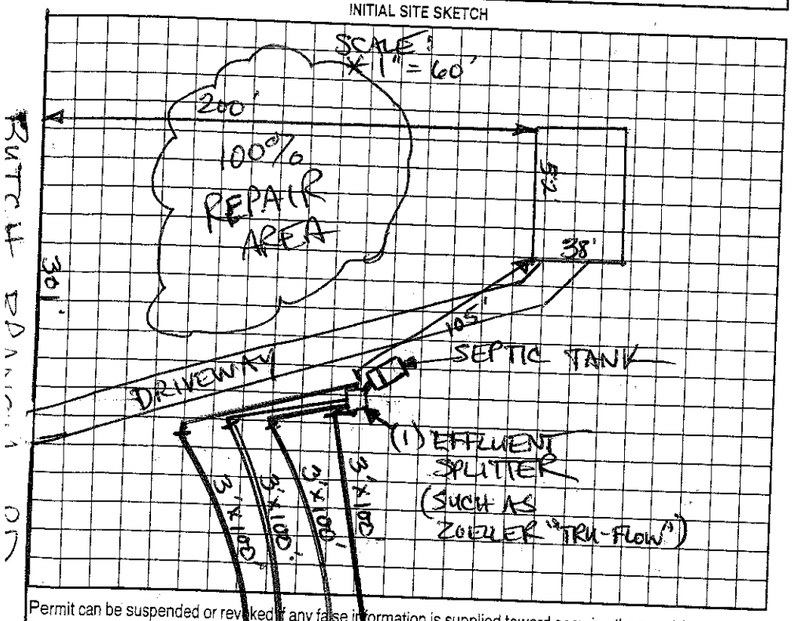

AS BUILT SKETCH

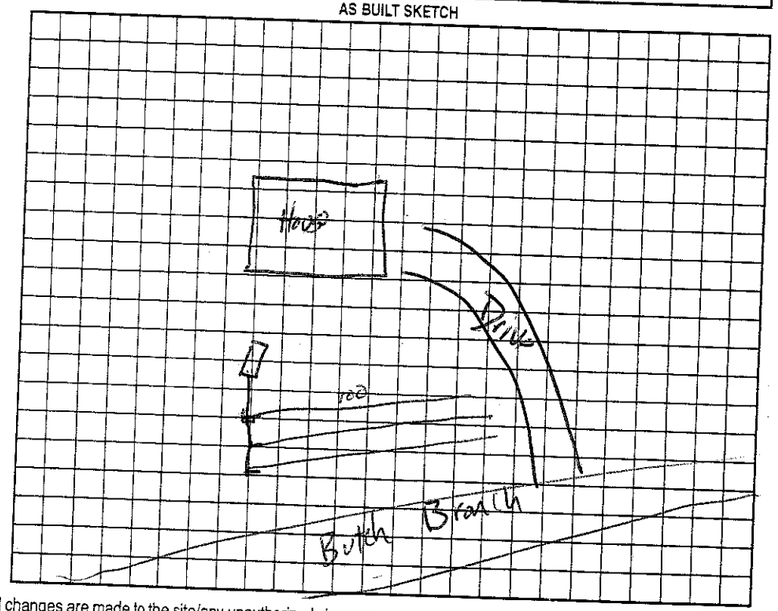

Permit can be suspended or revoked if any false information is supplied toward securing the permit/any unauthorized changes are made to the site/any unauthorized changes are made in the installation of the system. Improvement Permit with plat valid without expiration. Improvement Permit with site plan valid for sixty months. Authorization to Construct is valid for a period equal to that of Improvement Permit – not to exceed sixty months.

Signed: Brenda Jordan date 7-25-05 Installed by: C&S

Improvement Permit by: Christopher M. Sherrill, RS, LSS date 7-22-05 Operation Permit by: date 2-8-08

Authorization to Construct by: Christopher M. Sherrill, RS, LSS date 7-22-05 Existing System Inspection by: date

HEALTH DEPT. COPY: WHITE OWNER COPY (FINAL): YELLOW OWNER COPY (INITIAL): PINK