128625

COUNTY HEALTH DEPARTMENT

STATESVILLE 704-878-5305 MOORESVILLE 704-664-5281

MENT PERMIT / AUTHORIZATION TO CONSTRUCT / OPERATION PERMIT / EXISTING SYSTEM INSPECTION

625 PIN# 4894-01-8348

CTOR ALLEN TATE REALTY - BRENDA JORDAN PHONE: Business (704) 450-3076 Home DATE 7-22-05

134-I TOWN CENTER DRIVE MOORESVILLE, NC 28117

N TL HWY 901 TR WARREN BRIDGE RD TL BUTCH BRANCH RD PROPERTY ON RIGHT

BLOCK / SECTION LOT LOT AREA 9.804 SITE CLASS. PS DESIGN FLOW 480 L.T.A.R. 0.30 GPD/FT2

0 Gallons; STB 1082 Date 6-1-07

Gallons; PT Date

Model Serial No

Fields 1 Square Feet 1600 Linear Feet 400

4) Trench Width 36" Max Trench Bottom Depth 30" Gravel Depth N/A

☑ New System ☐ Repair System Type: I II III IV V VI

System Description: GRAVITY, 25% REDUCTION

Repair System Description: SAME

Maintenance Agreement Required: ☐ Yes ☑ No

☑ House/Mod. Home No. Bedrooms 4-3

☐ Mobile Home No. Bathrooms

☐ Business No. Employees

☐ Other

☐ Slab ☑ Crawl Space ☐ Basement w/plumbing ☐ Basement w/o plumbing

Water Supply: ☑ Individual ☐ Public ☐ Community


D INSTALL SYSTEM ON CONTOUR

N ALL SETBACKS


Comments/Conditions: Yellow Flag

24' x 49'

INITIAL SITE SKETCH

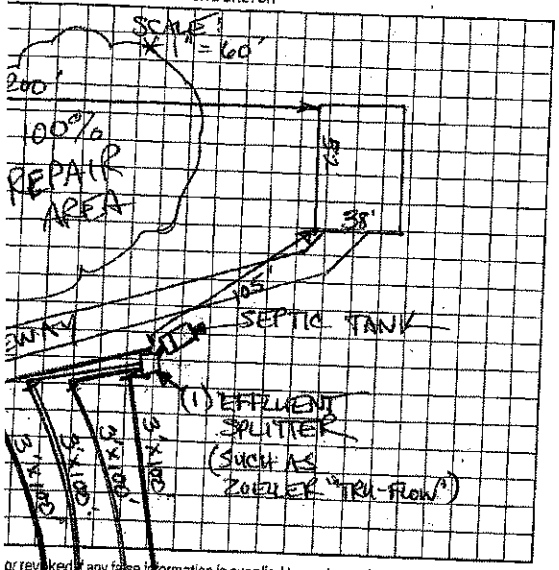

AS BUILT SKETCH

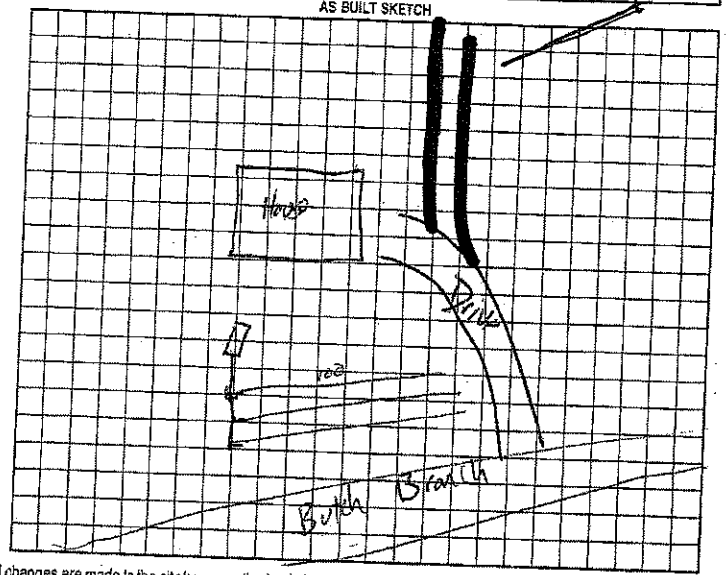

or revoked if any false information is supplied toward securing the permit/any unauthorized changes are made to the site/any unauthorized changes are made in the installation of the system. Improvement out expiration. Improvement Permit with site plan valid for sixty months. Authorization to Construct is valid for a period equal to that of Improvement Permit – not to exceed sixty months.

date 7-25-05 Installed by: C&S

by: Christopher M. Sherrill RS, LSS date 7-22-05 Operation Permit by: date 2-8-08

by: Christopher M. Sherrill RS, LSS date 7-22-05 Existing System Inspection by: date

HEALTH DEPT. COPY: WHITE OWNER COPY (FINAL): YELLOW OWNER COPY (INITIAL): PINK

Location of the proposed Carport **addition does not appear to ~~impact~~ the existing on-site septic system.**NOTE:** [signature] **REHS**

Date: 9-24-12

ICHD-Environmental Health Division