pg 125 (II)

IREDELL COUNTY HEALTH DEPARTMENT

THIS PERMIT VOIDS PREVIOUS ISSUED 9-27-00

STATESVILLE 704-878-5305 MOORESVILLE 704-664-5281

IMPROVEMENT PERMIT / AUTHORIZATION TO CONSTRUCT / OPERATION PERMIT / EXISTING SYSTEM INSPECTION

PERMIT# 091966 PIN# 4844 11 8280 (PT) DATE 3-14-01

OWNER OR CONTRACTOR CINDY ROBBINS PHONE: Business Home

ADDRESS 148 BUTCH BRANCH ROAD UNION GROVE NC 28689

LOCATION I-77 N, TL NC 901, TR WARREN BRIDGE RD TL BUTCH BRANCH RD, 1ST DRIVE ON RIGHT

SUBDIVISION BLOCK / SECTION LOT LOT AREA 1.977 ACRES SITE CLASS PS DESIGN FLOW 480 L.T.A.R. 0.30 GPD/FT²

Septic Tank: 1000 Gallons; STB 1017 Date 4-16-01
Pump Tank: Gallons; PT Date
Pump Make: Model Serial No.
Nitrification Field: No Fields 1 Square Feet 1600 Linear Feet 533
No Lines FOUR Trench Width 36" Max Trench Bottom Depth 24"-36" Gravel Depth 12"

☒ New System ☐ Repair System Type: I (II) III. IV. V. VI
System Description: CONVENTIONAL, GRAVITY
Repair System Description: CONVENTIONAL, GRAVITY
Maintenance Agreement Required: ☐ Yes ☒ No


☒ House/Mod. Home No. Bedrooms 4
☐ Mobile Home No. Bathrooms 4 1/2
☐ Business No. Employees
☐ Other
☐ Slab ☒ Crawl Space ☐ Basement w/plumbing ☐ Basement wo/plumbing

Water Supply: ☐ Individual ☒ Public ☐ Community

Comments:/Conditions: INSTALL LINES ON CONTOUR AS FLAGGED ON SITE BETWEEN 24" - 36" DEEP.

Comments:/Conditions: SEPTIC TANK WITH MARKER INSTALLED USING "Poly Lok" FILTER

INITIAL SITE SKETCH SCALE: 1" = 50'

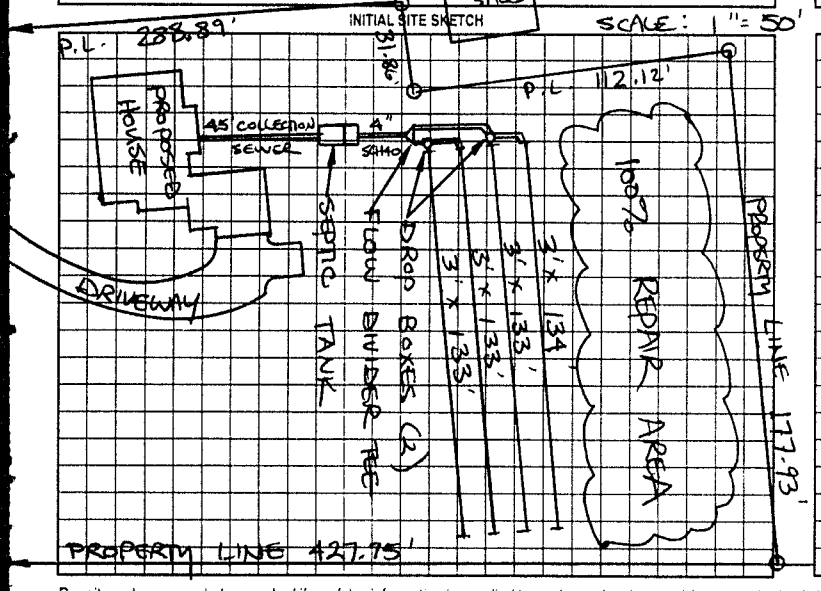

AS BUILT SKETCH

SYSTEM INSTALLED ACCORDING TO INITIAL SITE SKETCH

Permit can be suspended or revoked if any false information is supplied toward securing the permit/any unauthorized changes are made to the site/any unauthorized changes are made in the installation of the system. Improvement Permit with plat valid without expiration. Improvement Permit with site plan valid for sixty months. Authorization to Construct is valid for a period equal to that of Improvement Permit – not to exceed sixty months.

Signed: Cynthia B Robbins date 3/14/01 Installed by: STEVE JORDAN

Improvement Permit by: STEVE HEDRICK date 3-14-01 Operation Permit by: STEVE HEDRICK date 9-7-01

Authorization to Construct by: STEVE HEDRICK date 3-14-01 Existing System Inspection by: date

HEALTH DEPT. COPY: WHITE OWNER COPY (FINAL) YELLOW OWNER COPY (INITIAL) PINK