IREDELL COUNTY HEALTH DEPARTMENT

THIS PERMIT VOIDS PREVIOUS ISSUED 7-16-99

STATESVILLE 704-878-5305 MOORESVILLE 704-664-5281

IMPROVEMENT PERMIT / AUTHORIZATION TO CONSTRUCT / OPERATION PERMIT / EXISTING SYSTEM INSPECTION

PERMIT# 082725 PIN# 4844 21 7060 DATE 8-16-99

OWNER OR CONTRACTOR TIMOTHY HICKS PHONE: Business 872-4119 Home 539-4362

ADDRESS 378 WARREN BRIDGE ROAD UNION GROVE, N.C. 28689

LOCATION I-77 N, TL NC 901, TR WARREN BRIDGE ROAD, 1.1 MILE ON RIGHT AT BOX #378

SUBDIVISION BLOCK / SECTION LOT LOT AREA 4.17 ACRES SITE CLASS PS DESIGN FLOW 360 L.T.A.R. 0.30 GPD/FT2

Septic Tank: 1000 Gallons; STB 1012 Date 6-20-99

Pump Tank: Gallons; PT Date

Pump Make: Model Serial No.

Nitrification Field: No Fields Square Feet 50 TO 1200 linear Feet 300+

No Lines FOUR Trench Width 36" Max Trench Bottom Depth 36"

✓ New System Repair System Type: I II (III) IV V

System Description: 25% REDUCTION GRAVITY

Repair System Description: 25% REDUCTION GRAVITY

Maintenance Agreement Required Yes ✓ No

~~Gravel~~ Depth SAND 6" Slab ~~Crawl Space~~ Basement w/plumbing Basement w/o plumbing

~~House~~/Mod. Home ~~Mobile Home~~ ~~Business~~ Other


No. Bedrooms 3 No. Bathrooms 2 No. Employees

Water Supply: ☐ Individual ☑ Public ☐ Community


Comments/Conditions: INSTALL FIFTY (50) CHAMBERS OR THIRTY (30) HDS SECTIONS ON CONTOUR TO ACHIEVE 25% REDUCTION SYSTEM.

Comments Conditions SEPTIC TANK WITH RISERS INSTALLED ACCORDING TO INITIAL SITE SKETCH - "POLY LOK" FILTER INSTALLED. CHECKED 8-23-99 RH

INITIAL SITE SKETCH

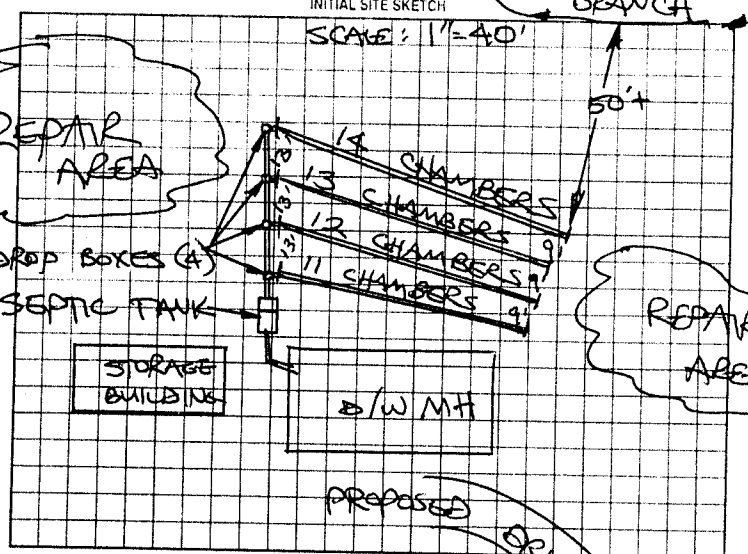

AS BUILT SKETCH

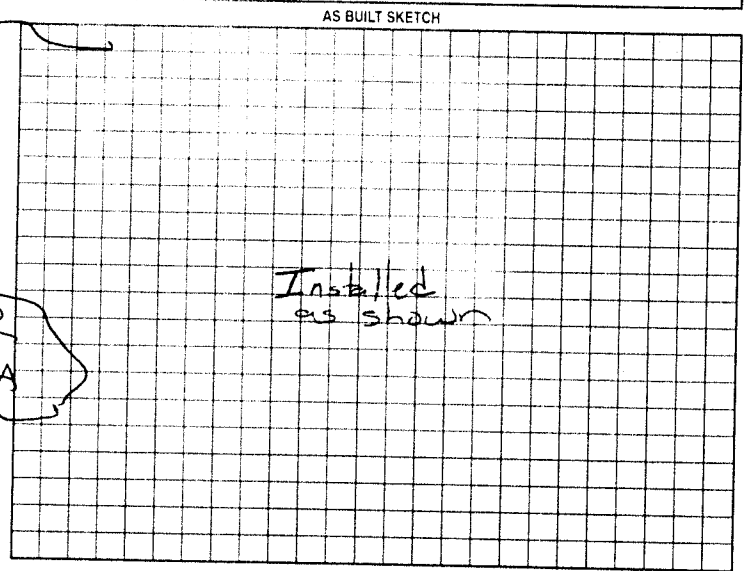

Permit can be suspended or revoked if any false information is supplied toward securing the permit; any unauthorized changes are made to the site/any unauthorized changes are made in the installation of the system. Improvement Permit with plat valid without expiration. Improvement Permit with site plan valid for sixty months. Authorization to Construct is valid for a period equal to that of Improvement Permit – not to exceed sixty months.

Signed: Steve W Jerkins 8/18/99 date

Improvement Permit by: STEVE HEDRICK date 8-16-99

Authorization to Construct by: STEVE HEDRICK date 8-16-99

Installed by: Tommy Frye

Operation Permit by: 9/14 C.O. RS date 8-24-99

Existing System Inspection by: date

HEALTH DEPT COPY WHITE OWNER COPY (FINAL) YELLOW OWNER COPY (INITIAL) PINK