IREDELL COUNTY HEALTH DEPARTMENT

STATESVILLE 704-878-5305 MOORESVILLE 704-664-5281

IMPROVEMENT PERMIT / AUTHORIZATION TO CONSTRUCT / OPERATION PERMIT / EXISTING SYSTEM INSPECTION

PERMIT# REPAIR PIN# DATE 3-5-99

OWNER OR CONTRACTOR JAMES O. WHITE PHONE: Business Home 539-4972

ADDRESS 455 WARREN BRIDGE ROAD, UNION GROVE NC 28689 # 455

LOCATION I-77 North, TL NC 901, TR WARREN BRIDGE RD, ON LEFT AT BOX # 455

SUBDIVISION BLOCK / SECTION LOT LOT AREA 111.5 ACRES SITE CLASS PS DESIGN FLOW 360 L.T.A.R. EXISTING

Septic Tank: 1000 Gallons; STB Date

Pump Tank: Gallons; PT Date

Pump Make: Model Serial No.

Nitrification Field: No Fields 1 Square Feet 450 Linear Feet 150

No Lines ONE Trench Width 36" Max Trench Bottom Depth 36" Gravel Depth 12"

☐ New System ☑ Repair System Type: I (II) III IV V VI

System Description: CONVENTIONAL GRAVITY

Repair System Description: CONV. GRAVITY

Maintenance Agreement Required: ☐ Yes ☑ No

☑ House/Mod. Home No. Bedrooms 3

☐ Mobile Home No. Bathrooms 2½

☐ Business No. Employees

☐ Other


☐ Slab ☑ Crawl Space ☐ Basement w/plumbing ☐ Basement wo/plumbing

Water Supply: ☐ Well ☐ Public ☐ Community


Comments/Conditions: REPLACE SANITARY TEE IN SEPTIC TANK IF NECESSARY THIS PERMIT SERVES AS NOTICE OF VIOLATION

Comments/Conditions

INITIAL SITE SKETCH

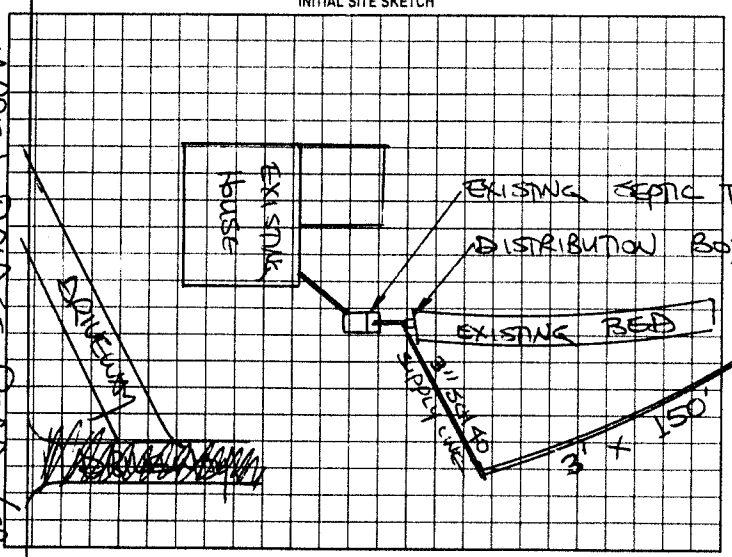

AS BUILT SKETCH

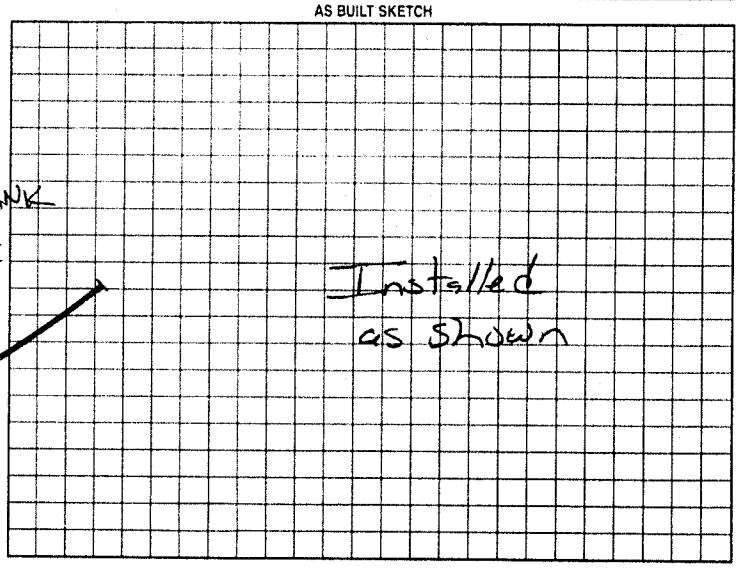

Permit can be suspended or revoked if any false information is supplied toward securing the permit/any unauthorized changes are made to the site/any unauthorized changes are made in the installation of the system. Improvement Permit with plat valid without expiration. Improvement Permit with site plan valid for sixty months. Authorization to Construct is valid for a period equal to that of Improvement Permit – not to exceed sixty months.

Signed: James O. White date 3-5-99 Installed by A-1 Backhoe

Improvement Permit by: STEVE HEDRICK date 3-5-99 Operation Permit by: [illegible] RS date 3-31-99

Authorization to Construct by: STEVE HEDRICK date 3-5-99 Existing System Inspection by: date

HEALTH DEPT COPY WHITE OWNER COPY (FINAL) YELLOW OWNER COPY (INITIAL) PINK