IREDELL COUNTY HEALTH DEPARTMENT

Authorization to Construct

STATESVILLE 704-878-5305 MOORESVILLE 704-664-5281

IMPROVEMENT PERMIT / ~~CERTIFICATE OF COMPLETION~~ / OPERATION PERMIT / EXISTING SYSTEM INSPECTION

PROPERTY DESCRIPTION NO. 23576 DATE 4/27/96 TAX MAP NO. 16M-A-17 Watershed: ☑ Yes ☐ No

OWNER OR CONTRACTOR William Eric Stevenson PHONE: Business _____ Home 528-0849

ADDRESS 174 Westmoreland Rd. Mooresville 28115

LOCATION 901 - TR Warren Bridge Rd - TR Witch Rd lot on left

SUBDIVISION _____ BLOCK / SECTION _____ LOT _____ LOT AREA 26.23 SITE CLASS. PS ped 195 DESIGN FLOW 450 gpd L.T.A.R. .3 gpd/ft

Septic Tank: 1000 Gallons; STB 794 Date 3-15-96

Pump Tank: _____ Gallons; PT _____ Date _____

Pump Make: _____ Model _____ Serial No. _____

Nitrification Field: No Fields 1 Square Feet 1600 Linear Feet 533

No Lines 4 Trench Width 36" Max Trench Bottom Depth 36" Gravel Depth 12"

☑ New System ☐ Repair System Type: I II III IV V VI

System Description: Gravity Convention

Repair System Description: Gravity Convention

Maintenance Agreement Required: ☐ Yes ☑ No

☑ House/Mod. Home No. Bedrooms 4

☐ Mobile Home No. Bathrooms 3

☐ Business No. Employees ____

☐ Other _____

☐ Slab ☑ Crawl Space ☐ Basement w/plumbing ☐ Basement wo/plumbing


Water Supply: ☑ Individual ☐ Community ☐ Public

Comments:

Comments:

Not to Scale

INITIAL SITE SKETCH

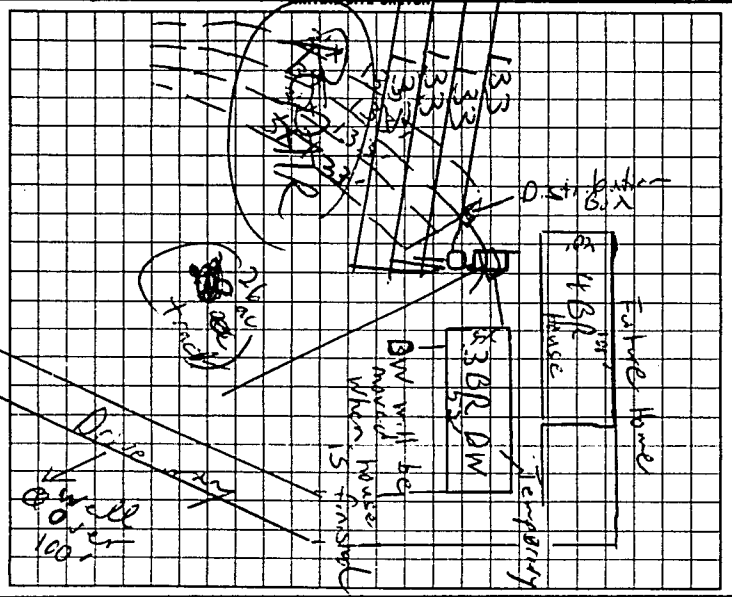

AS BUILT SKETCH

SYSTEM INSTALLED ACCORDING TO INITAL SITE SKETCH

I understand that this permit can be suspended or revoked if any false information is supplied toward securing the permit/any unauthorized changes are made to the site/any unauthorized changes are made in the installation of the system.

Signed: _____

Improvement Permit by: C. Brady Thrasher EHST date 4/27/96

Authorization to Construct

Existing System Inspection by: C. Brady Thrasher EHST date 4/27/96

Installed by: A-1 BACKHOE

Certificate of Completion by: _____ date _____

Operation Permit by: STEVE HEDRICK date 6-3-96

HEALTH DEPT COPY WHITE | INSPECTION COPY (FINAL) GREEN | OWNER COPY (FINAL) YELLOW | INSPECTION COPY (INITIAL) PINK | OWNER COPY (INITIAL) GOLD

Authorization to Construct is valid for 60 months from issue date.

002293