IREDELL COUNTY HEALTH DEPARTMENT

STATESVILLE 704-878-5305 MOORESVILLE 704-664-5281

IMPROVEMENT PERMIT / AUTHORIZATION TO CONSTRUCT / OPERATION PERMIT / EXISTING SYSTEM INSPECTION

PERMIT# Repair PIN# DATE 3-22-99

OWNER OR CONTRACTOR Tammy Melton PHONE: Business Home 539-4122

ADDRESS 140 Ponds End Ln Union Grove

LOCATION 77N TL901 TR Warren Bridge TR mitch Rd go to pavement end 1st drive on (L) at end

SUBDIVISION BLOCK / SECTION LOT LOT AREA SITE CLASS DESIGN FLOW 360 L.T.A.R. Existing

Septic Tank: 1000 Ex Gallons: STB Date

Pump Tank: Gallons: PT Date

Pump Make: Model Serial No.

Nitrification Field: No Fields 1 Square Feet Linear Feet 300

No Lines 3 Trench Width 36in Max Trench Bottom Depth 36in Gravel Depth 12in

☐ New System ☒ Repair System Type: I (II) III, IV, V, VI

System Description:

Repair System Description: Gravity Conventional

Maintenance Agreement Required: ☐ Yes ☒ No

☒ House/Mod. Home No. Bedrooms 3

☐ Mobile Home No. Bathrooms 1

☐ Business No. Employees

☐ Other


☐ Slab ☒ Crawl Space ☐ Basement w/plumbing ☐ Basement wo/plumbing

Water Supply: ☒ Individual ☐ Public ☐ Community


Comments/Conditions: This permit serves as Notice of Violation. May or may not be able to tie into old system - Table use dist Box Install 3 line @ 100 ft

Comments/Conditions: Need To tie sink drain into tank

INITIAL SITE SKETCH

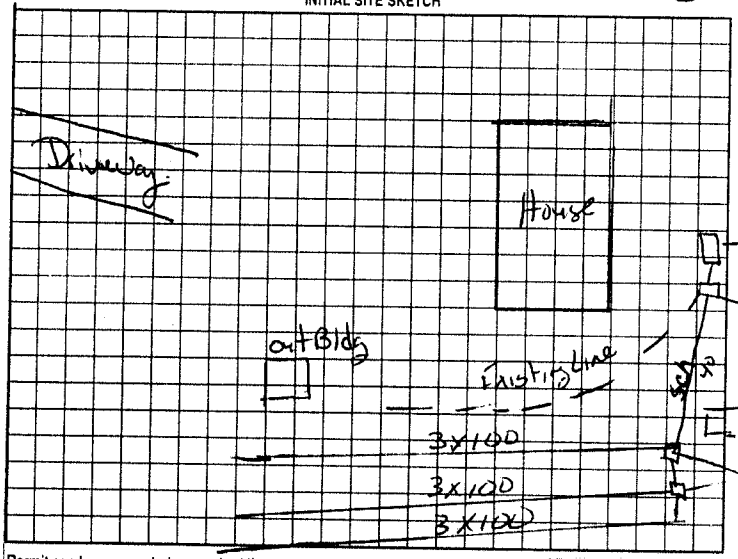

AS BUILT SKETCH

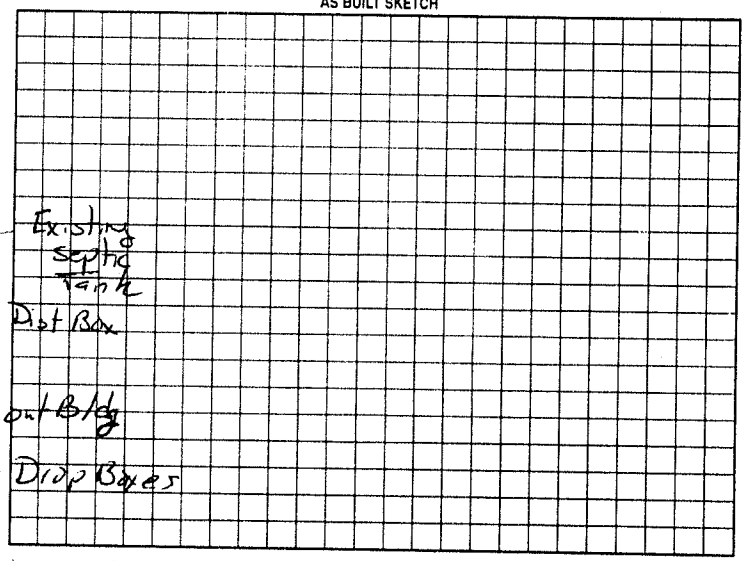

Permit can be suspended or revoked if any false information is supplied toward securing the permit/any unauthorized changes are made to the site/any unauthorized changes are made in the installation of the system. Improvement Permit with plat valid without expiration. Improvement Permit with site plan valid for sixty months. Authorization to construct is valid for a period equal to that of Improvement Permit – not to exceed sixty months.

Signed: Tammy M Melton date

Improvement Permit by: Mark C Ott RS date 3-22-99

Authorization to Construct by: Mark C Ott RS date 3-22-99

Installed by: Sammy Reavis

Operation Permit by: Mark C Ott RS date 4-7-99

Existing System Inspection by date

HEALTH DEPT COPY: WHITE OWNER COPY (FINAL): YELLOW OWNER COPY (INITIAL): PINK