IREDELL COUNTY HEALTH DEPARTMENT

STATESVILLE 704-878-5305 MOORESVILLE 704-664-5281

IMPROVEMENT PERMIT / AUTHORIZATION TO CONSTRUCT / OPERATION PERMIT / EXISTING SYSTEM INSPECTION

PERMIT# 110915 PIN# 4844-40-7898 DATE 1-28-03

OWNER OR CONTRACTOR MAURICIO & ANGELA MARTINEZ PHONE: Business Home 704-539-5692

ADDRESS 421 MITCH ROAD, UNION GROVE, NC 28689

LOCATION I-77 N, TL NC 901, TR WARREN BRIDGE ROAD, TR MITCH ROAD, 0.6 MILE ON RIGHT AT BOX #421

SUBDIVISION BLOCK / SECTION LOT LOT AREA 0.85 ACRE SITE CLASS. PS DESIGN FLOW 600 L.T.A.R. 0.30 GPD/FT²

Septic Tank: 1500 Gallons; STB 619 Date 11-18-02
Pump Tank: Gallons; PT Date
Pump Make: Model Serial No.
Nitrification Field: No Fields 1 Square Feet ET 810 Linear Feet 200
No Lines FIVE Trench Width 36" Max Trench Bottom Depth 30" Gravel Depth N/A

☑ New System ☐ Repair System Type: I, II, (III), IV, V, VI
System Description: 25% REDUCTION GRAVITY
Repair System Description: 50% REDUCTION, LOW-PRESSURE
Maintenance Agreement Required: ☐ Yes ☑ No


☐ House/Mod. Home No. Bedrooms 5
☑ Mobile Home No. Bathrooms 2
☐ Business No. Employees
☐ Other
☐ Slab ☑ Crawl Space ☐ Basement w/plumbing ☐ Basement wo/plumbing

Water Supply: ☑ Individual ☐ Public ☐ Community WELL


Comments/Conditions: ① REPLACE EXISTING 1000 GAL. SEPTIC TANK WITH NEW 1500 GAL. SEPTIC TANK ② INSTALL 25% REDUCTION SYSTEM IN FIVE LINES AS FLAGGED ON CONTOUR

Comments/Conditions: ① SEPTIC TANK WITH RISERS AND MARKER INSTALLED USING "ZABEL" FILTER ② SYSTEM EXPANDED DURING PERIOD OF WET SOIL CONDITIONS

INITIAL SITE SKETCH SCALE: 1"=40'

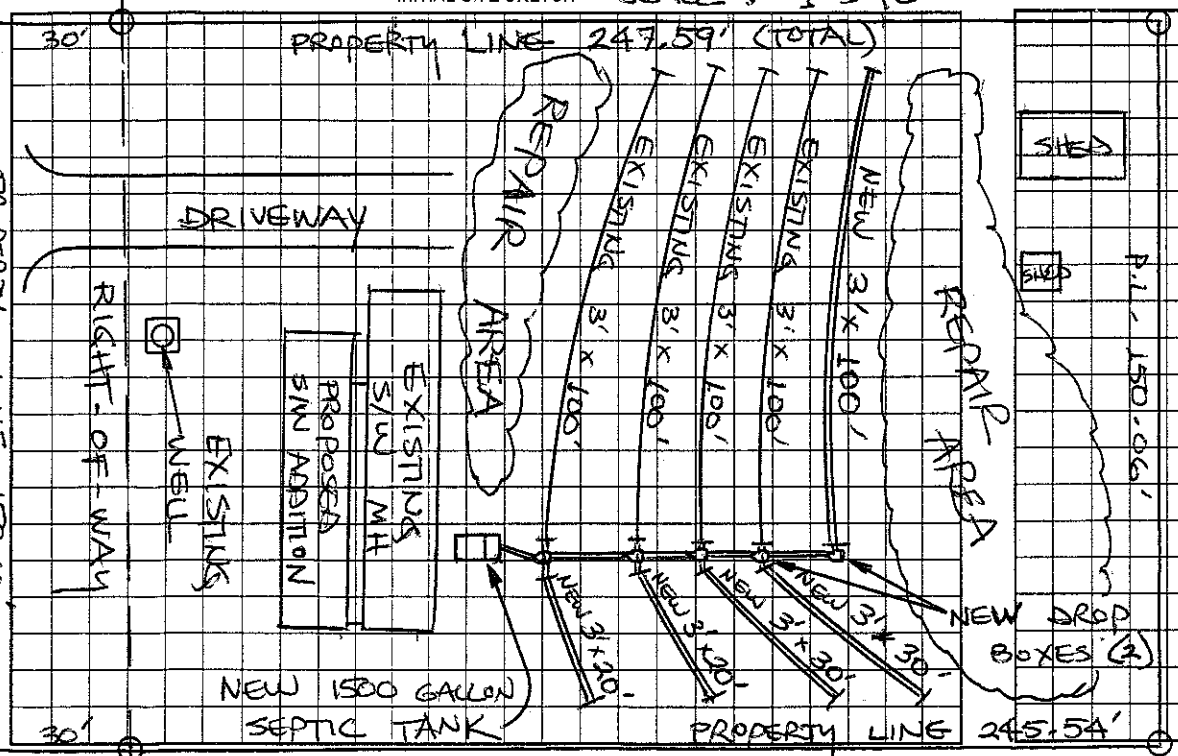

AS BUILT SKETCH

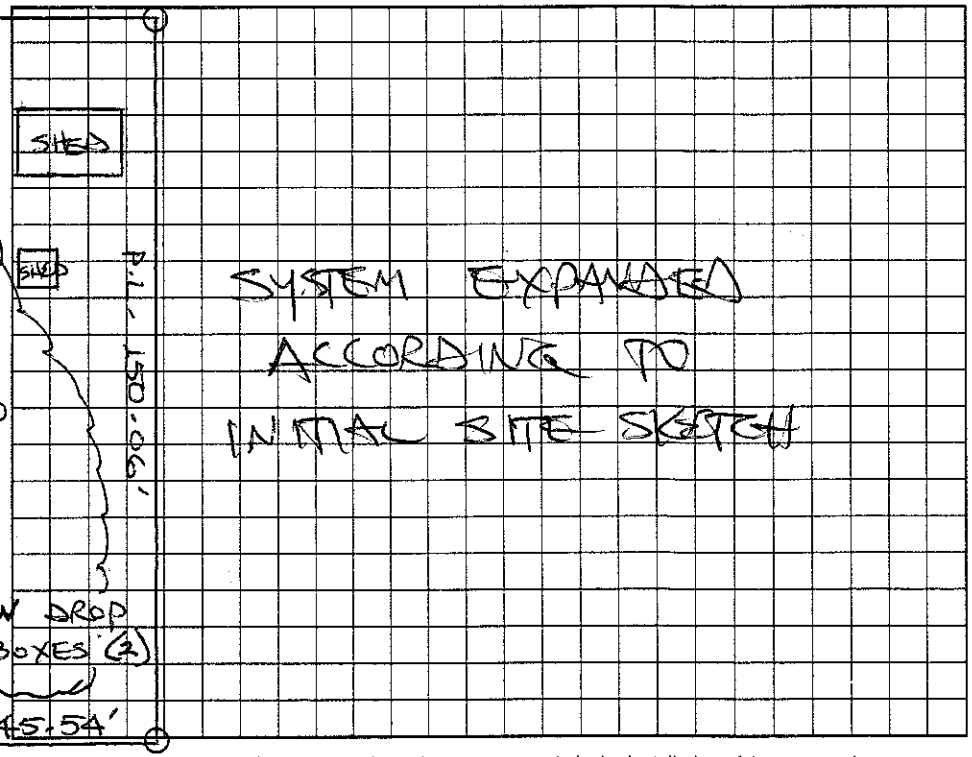

Permit can be suspended or revoked if any false information is supplied toward securing the permit/any unauthorized changes are made to the site/any unauthorized changes are made in the installation of the system. Improvement Permit with plat valid without expiration. Improvement Permit with site plan valid for sixty months. Authorization to Construct is valid for a period equal to that of Improvement Permit – not to exceed sixty months.

Signed: Angela Martinez date Installed by: SAMMY REAVIS

Improvement Permit by: STEVE HEDRICK date 1-28-03 Operation Permit by: STEVE HEDRICK date 4-29-03

Authorization to Construct by: STEVE HEDRICK date 1-28-03 Existing System Inspection by: date

HEALTH DEPT. COPY: WHITE OWNER COPY (FINAL): YELLOW OWNER COPY (INITIAL): PINK