IREDELL COUNTY HEALTH DEPARTMENT

STATESVILLE 704-878-5305 MOORESVILLE 704-664-5281

IMPROVEMENT PERMIT / CERTIFICATE OF COMPLETION / OPERATION PERMIT / EXISTING SYSTEM INSPECTION

PROPERTY DESCRIPTION NO. 069431 DATE 9-18-97 TAX MAP NO. 4844 40 6879 (PT) Watershed: ☐ Yes ☑ No

OWNER OR CONTRACTOR PAUL BURNS PHONE: Business Home 873-6257

ADDRESS 785 CHURCH LAKE ROAD, STATESVILLE, NC 28625

LOCATION NC 115 N, TR NC 901, TL WARREN BRIDGE, TR MITCH RD, ON RIGHT JUST PAST POND'S END,

SUBDIVISION BLOCK / SECTION 1 LOT LOT AREA 0.849 AC SITE CLASS. PS DESIGN FLOW 360 L.T.A.R. 0.30 GPD/FT²

Septic Tank: 1000 Gallons; STB 620 Date 1-11-98

Pump Tank: Gallons; PT Date

Pump Make: Model Serial No.

Nitrification Field: No Fields 1 Square Feet 1200 Linear Feet 400

No Lines FOUR Trench Width 36" Max Trench Bottom Depth 30" Gravel Depth 12"

☑ New System ☐ Repair System Type: I, (II), III, IV, V, VI

System Description: CONVENTIONAL GRAVITY

Repair System Description: CONV. GRAVITY

Maintenance Agreement Required: ☐ Yes ☑ No

☐ House/Mod. Home ☑ Mobile Home ☐ Business ☐ Other

No. Bedrooms 3 No. Bathrooms 2 No. Employees


☐ Slab ☑ Crawl Space ☐ Basement w/plumbing ☐ Basement wo/plumbing

Water Supply: ☑ Individual ☐ Community ☐ Public WELL


Comments: ① KEEP SYSTEM MINIMUM 100' FROM WELL
② INSTALL LINES ON CONTOUR, NO DEEPER THAN 30"

Comments:

INITIAL SITE SKETCH SCALE: 1"=50'

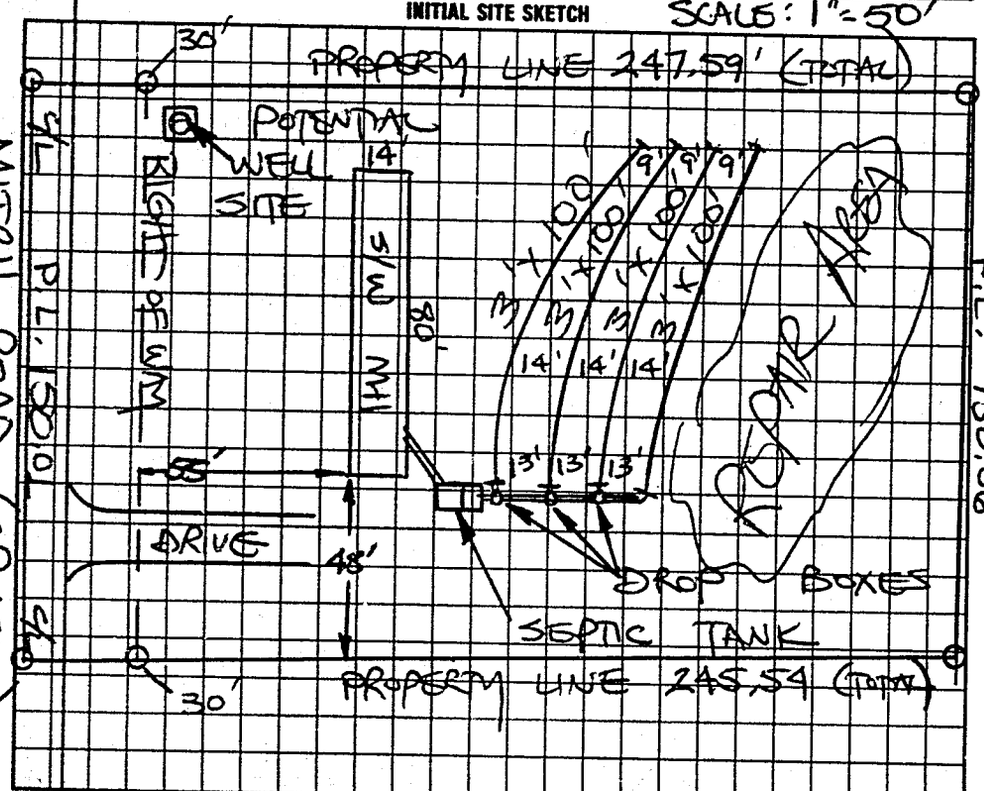

AS BUILT SKETCH

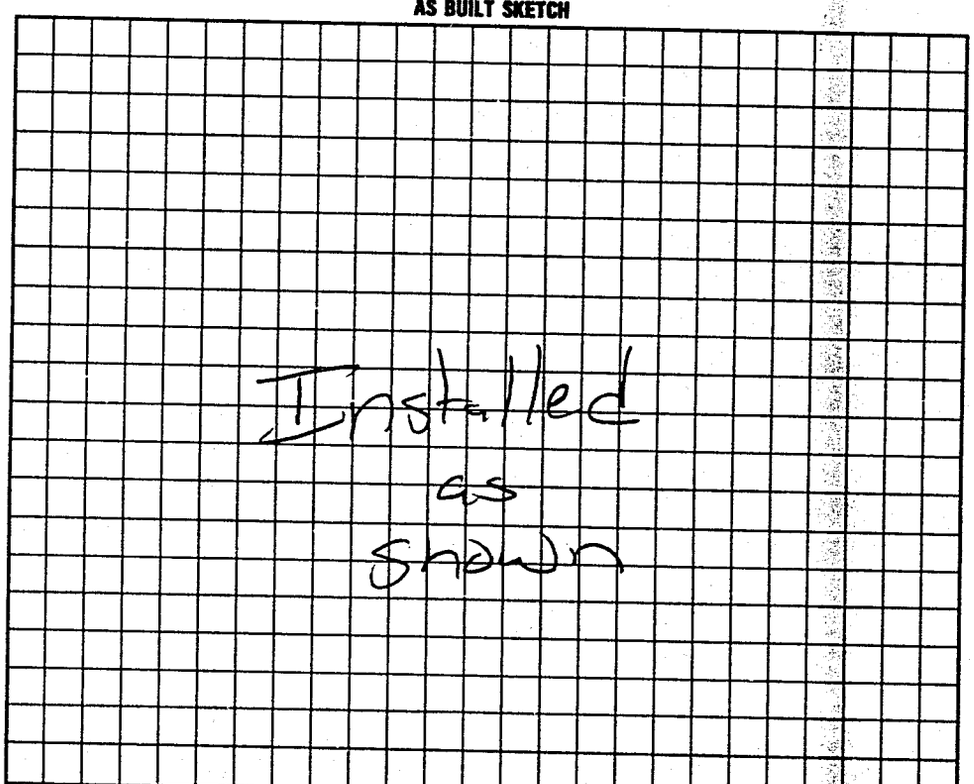

I understand that this permit can be suspended or revoked if any false information is supplied toward securing the permit/any unauthorized changes are made to the site/any unauthorized changes are made in the installation of the system. Improvement Permit is valid for 60 months from date of issuance. AUTHORIZATION TO CONSTRUCT IS VALID FOR 60 MONTHS FROM DATE OF ISSUANCE.

Signed: X Paul Burns

Improvement Permit by: STEVE HEDRICK date 9-18-97

AMD. TO CONST. ~~Existing System Inspection~~ by: STEVE HEDRICK date 9-18-97

Installed by: Sammy Reavis

~~Certificate of Completion by:~~ date

Operation Permit by: Mary C Ortiz RS date 2-25-98

HEALTH DEPT. COPY: WHITE INSPECTION COPY (FINAL): GREEN OWNER COPY (FINAL): YELLOW INSPECTION COPY (INITIAL): PINK OWNER COPY (INITIAL): GOLD