IREDELL COUNTY HEALTH DEPARTMENT

STATESVILLE 704-878-5305 MOORESVILLE 704-664-5281

IMPROVEMENT PERMIT / CERTIFICATE OF COMPLETION / OPERATION PERMIT / EXISTING SYSTEM INSPECTION

PROPERTY DESCRIPTION NO 25498 DATE 11-18-96 TAX MAP NO 16M-A-10 (PART OF) Watershed

OWNER OR CONTRACTOR JAMES & MINNIE HICKS PHONE: Business Home 546-7789

ADDRESS 2805 SANDY SPRINGS ROAD HARMONY, NC 28634

LOCATION I-77 N, TL NC 901, TR WARREN BRIDGE, TR MATCH ROAD, TL POND SENED, 1ST ON RIGHT

SUBDIVISION BLOCK / SECTION LOT LOT AREA ~30 ACRES SITE CLASS PS DESIGN FLOW 240 L.T.A.R. 1.3 GPD/FT²

Septic Tank: 1000 Gallons; STB 1012 Date 8-9-96

Pump Tank: Gallons; PT Date

Pump Make: Model Serial No

Nitrification Field: No Fields 1 Square Feet 810 Linear Feet 270

No Lines THREE Trench Width 36" Max Trench Bottom Depth 32" Gravel Depth 12"

(V) New System ( ) Repair System Type: I (II), IV, V, VI

System Description: CONVENTIONAL GRAV.

Repair System Description: CONV. GRAVITY

Maintenance Agreement Required: ( ) Yes (V) No

( ) House/Mod. Home No. Bedrooms 3

(V) Mobile Home No. Bathrooms 1

( ) Business No. Employees

( ) Other


( ) Slab (V) Crawl Space ( ) Basement w/plumbing ( ) Basement w/o plumbing

Water Supply: (V) Individual ( ) Community ( ) Public WELL

Comments (1) USE TWO DROP BOXES FOR SERIAL DISTRIBUTION (2) KEEP SYSTEM MINIMUM 100' FROM WELL

Comments:

INITIAL SITE SKETCH

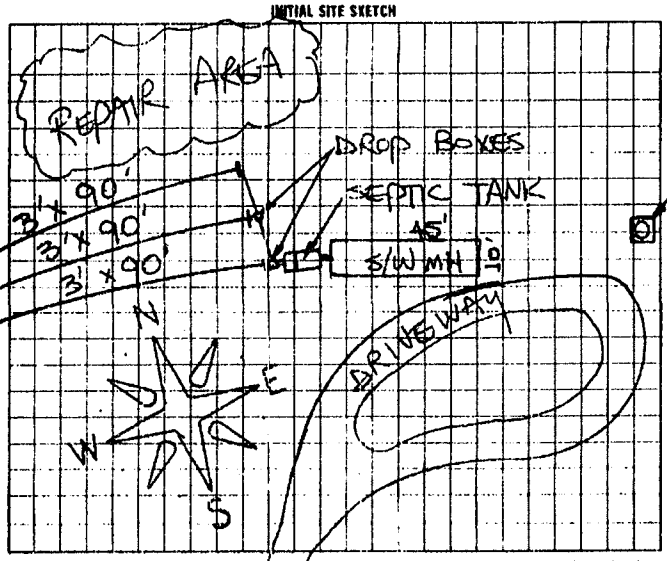

AS BUILT SKETCH

SYSTEM INSTALLED DURING PERIOD OF EXTREME WETNESS. SITE WAS VERY MUDDY & RUTTED BY BACKHOE TIRES.

I understand that the permit can be suspended or revoked if any false information is supplied toward securing the permit/any unauthorized changes are made to the site/any unauthorized changes are made in the installation of the system

Auth. to Const. is valid for a period equal to the validity of the IP not to exceed five years. IP w/site plan is valid five ye

Signed: Minnie Hicks Installed by: JEFF HURLBUT

Improvement Permit by STEVE HEDRICK date 11-18-96 Certificate of Complet on by: date

Authorization to Construct STEVE HEDRICK date 11-18-96 Operation Permit by STEVE HEDRICK date 12-5-96

XXXXXXXXXXXXXXXX

Section Supervisor/Inspector by

HEALTH DEPT COPY WHITE INSPECTION COPY (FINAL) GREEN OWNER COPY (FINAL) YELLOW INSPECTION COPY (PRIOR) PINK OWNER COPY (PRIOR) GOLD

JAN. 4, 1989 23:06