IREDELL COUNTY HEALTH DEPARTMENT

STATESVILLE 704-878-5305 MOORESVILLE 704-664-5281

IMPROVEMENT PERMIT / AUTHORIZATION TO CONSTRUCT / OPERATION PERMIT / EXISTING SYSTEM INSPECTION

PERMIT# 087593 PIN# 4844 41 4705 DATE 2-4-00

OWNER OR CONTRACTOR JAMES HICKS PHONE: Business Home 546-7739

ADDRESS 2805 SANDY SPRINGS RD, HARMONY, NC 28634

LOCATION I-77N, TL NC 901, TR WARREN BRIDGE, TR MITCH, TL POND'S END, TR 1ST DRIVE BACK OFF ROAD

SUBDIVISION BLOCK / SECTION LOT LOT AREA 30 ACRES SITE CLASS PS DESIGN FLOW 240 L.T.A.R. 0.3 GPD/FT²

Septic Tank: 1000 Gallons; STB Date

Pump Tank: Gallons; PT Date

Pump Make: Model Serial No.

Nitrification Field: No Fields 1 Square Feet 810 Linear Feet 270

No Lines THREE Trench Width 36" Max Trench Bottom Depth 36" Gravel Depth 12"

☑ New System ☐ Repair System Type: I II III IV V VI

System Description: CONV. GRAVITY

Repair System Description: CONV. GRAVITY

Maintenance Agreement Required: ☐ Yes ☑ No

☐ House/Mod. Home ☑ Mobile Home ☐ Business ☐ Other

No. Bedrooms 2 No. Bathrooms 1 No. Employees

☐ Slab ☐ Crawl Space ☐ Basement w/plumbing ☐ Basement wo/plumbing


Water Supply: ☑ Individual ☐ Public ☐ Community WELL

Comments/Conditions:

Comments/Conditions: ① MH ON SITE AT TIME OF INSPECTION ② SYSTEM ORIGINALLY INSTALLED DURING PERIOD OF SOIL WETNESS.

INITIAL SITE SKETCH

AS BUILT SKETCH SCALE: 1"=40'

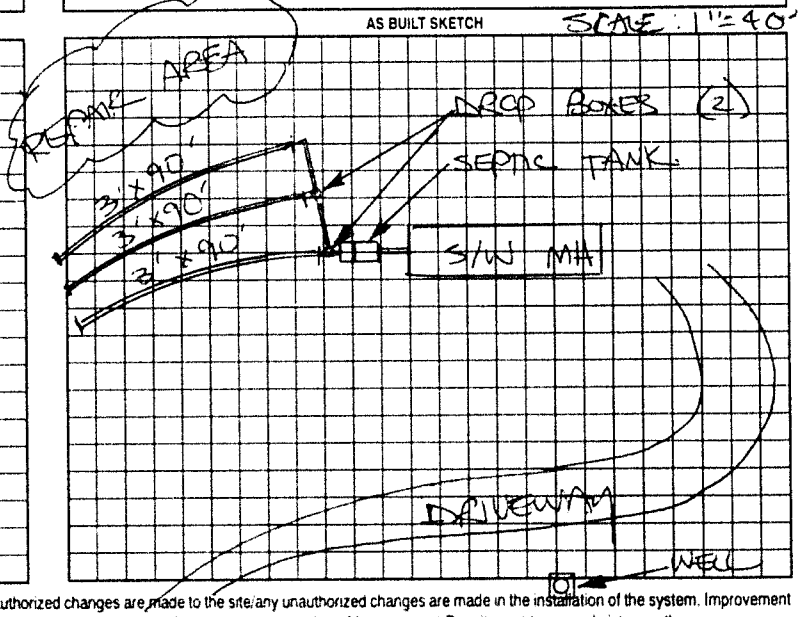

Permit can be suspended or revoked if any false information is supplied toward securing the permit/any unauthorized changes are made to the site/any unauthorized changes are made in the installation of the system. Improvement Permit with plat valid without expiration. Improvement Permit with site plan valid for sixty months. Authorization to Construct is valid for a period equal to that of Improvement Permit – not to exceed sixty months.

Signed: date Installed by:

Improvement Permit by: date Operation Permit by: date

Authorization to Construct by: date Existing System Inspection by: STEVE HEDRICK date 2-4-00

HEALTH DEPT. COPY: WHITE OWNER COPY (FINAL): YELLOW OWNER COPY (INITIAL): PINK