IREDELL COUNTY HEALTH DEPARTMENT

STATESVILLE 704-878-5305 MOORESVILLE 704-664-5281

IMPROVEMENT PERMIT / AUTHORIZATION TO CONSTRUCT / OPERATION PERMIT / EXISTING SYSTEM INSPECTION

PERMIT# 072925 PIN# 4844 82 2359 DATE 4-22-98

OWNER OR CONTRACTOR LINDA MORROW PHONE: Business Home 872-5173

ADDRESS 2908 EASTWAY DRIVE, STATESVILLE, NC 28625

LOCATION NC115N, TR NC901, TL HOWARDS BRIDGE RD, TL 2.2 MILES AT BOX 655, BACK OFF ROAD 0.4 MI

SUBDIVISION BLOCK / SECTION LOT LOT AREA 2.0 ACRE SITE CLASS PS DESIGN FLOW 240 L.T.A.R. 0.30 GPD/FT²

Septic Tank: 1000 Gallons; STB 312 Date 7-23-01

Pump Tank: Gallons; PT Date

Pump Make: Model Serial No.

Nitrification Field: No Fields 1 Square Feet 810 Linear Feet 270

No Lines THREE Trench Width 36" Max Trench Bottom Depth 36" Gravel Depth 12"

[X] New System [ ] Repair System Type: [ ] I [ ] II, IV, V, VI

System Description: CONVENTIONAL GRAVITY

Repair System Description: CONV. GRAVITY

Maintenance Agreement Required: [ ] Yes [X] No

[ ] Slab [X] Crawl Space [ ] Basement w/plumbing [ ] Basement wo/plumbing

[X] House/Mod. Home No. Bedrooms 1

[ ] Mobile Home No. Bathrooms 1

[ ] Business No. Employees


[ ] Other

Water Supply:
[X] Individual
[ ] Public
[ ] Community
WELL & SPRING


Comments:/Conditions:

Comments:/Conditions: SEPTIC TANK INSTALLED USING "ZABEL" FILTER REORIENTED AS SHOWN WITHOUT PRIOR HEALTH DEPT. APPROVAL.

INITIAL SITE SKETCH

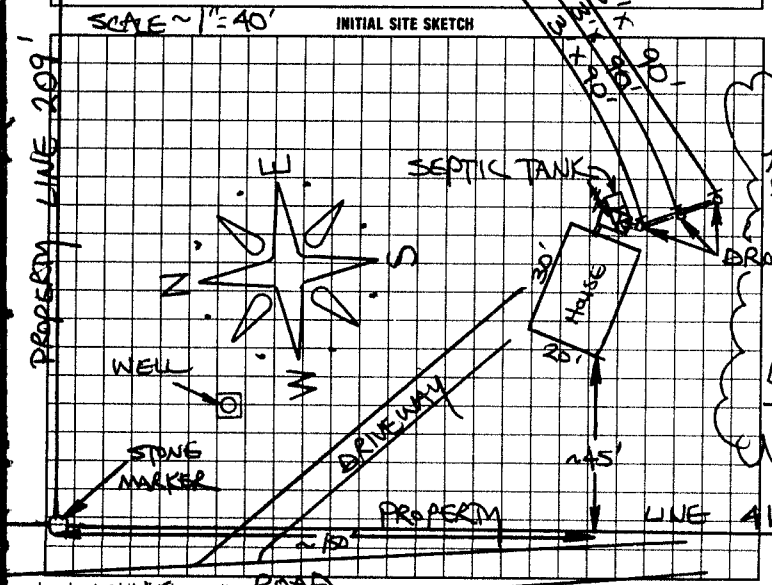

AS BUILT SKETCH

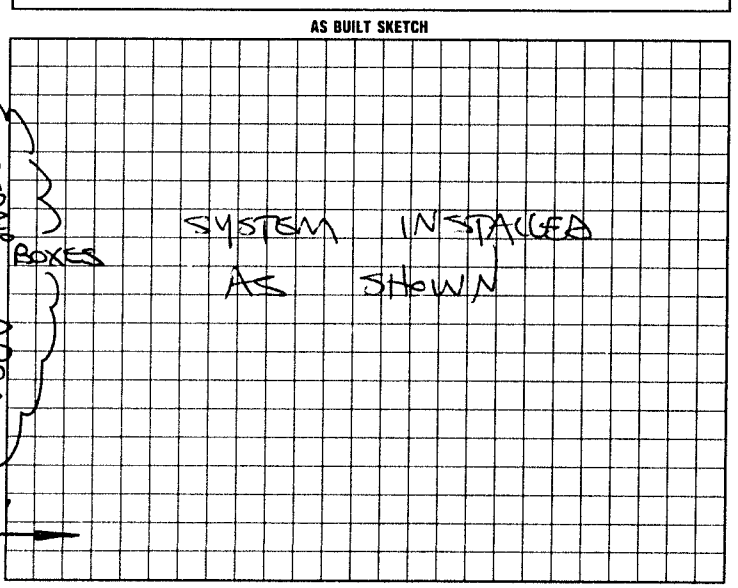

I understand that this permit can be suspended or revoked if any false information is supplied toward securing the permit/any unauthorized changes are made to the site/any unauthorized changes are made in the installation of the system. Improvement Permit with plat valid without expiration. Improvement Permit with site plan valid for sixty months. Authorization to Construct is valid for a period equal to that of Improvement Permit – not to exceed sixty months.

Signed: [signature] date 4/22/98

Improvement Permit by: STEVE HEDRICK date 4-22-98

Authorization to Construct by: STEVE HEDRICK date 4-22-98

Installed by: MARTY TUCKER

Operation Permit by: STEVE HEDRICK date 9-12-01

Existing System Inspection by: date

HEALTH DEPT. COPY: WHITE INSPECTION COPY (FINAL) GREEN OWNER COPY (FINAL) YELLOW INSPECTION COPY (INITIAL): PINK OWNER COPY (INITIAL): GOLD