IREDELL COUNTY HEALTH DEPARTMENT

STATESVILLE 704-878-5305 MOORESVILLE 704-664-5281

IMPROVEMENT PERMIT / AUTHORIZATION TO CONSTRUCT / OPERATION PERMIT / EXISTING SYSTEM INSPECTION

PERMIT# 116107 PIN# 4850-00-0771 DATE 11-5-03

OWNER OR CONTRACTOR FLEETWOOD HOMES OF TROUTMAN PHONE: Business 704-528-7120 Home

ADDRESS 1040 CHARLOTTE HWY, TROUTMAN, NC 28166

LOCATION 21 N, @ JOHNSONS @ OLD LOOP, ON RT BEF INTERSTATE

SUBDIVISION OLD GLORY BLOCK / SECTION 1 LOT 16 LOT AREA .656Ac SITE CLASS PS DESIGN FLOW 480 L.T.A.R. .35

Septic Tank: 1000 Gallons; STB 1012 Date 5-13-03
Pump Tank: Gallons; PT Date
Pump Make: Model Serial No.
Nitrification Field: No Fields 1 Square Feet EW 1920 Linear Feet 480'
No Lines 5x96" Trench Width 36" Max Trench Bottom Depth 36" Gravel Depth N/A

☒ New System ☐ Repair System Type: I, II, (III) IV, V, VI
System Description: 6 CAV CS510,20
Repair System Description: LP PAVEL
Maintenance Agreement Required: ☐ Yes ☒ No


☐ House/Mod. Home No. Bedrooms 4
☒ Mobile Home DW No. Bathrooms 2
☐ Business No. Employees
☐ Other
☐ Slab ☒ Crawl Space ☐ Basement w/plumbing ☐ Basement wo/plumbing

Water Supply: ☐ Individual ☒ Public ☐ Community

Comments:/Conditions: ① HOUSE BACK LINE PLOTTED IN RED. DRAINFIELD PLOTTED OUT COMPLETELY ② INSTALL LINES ON CONTOURS ③ MAINTAIN SETBACKS

Comments:/Conditions: SEPTIC TANK WITH MARKER INSTALLED USING "TUFFITE" FILTER

INITIAL SITE SKETCH

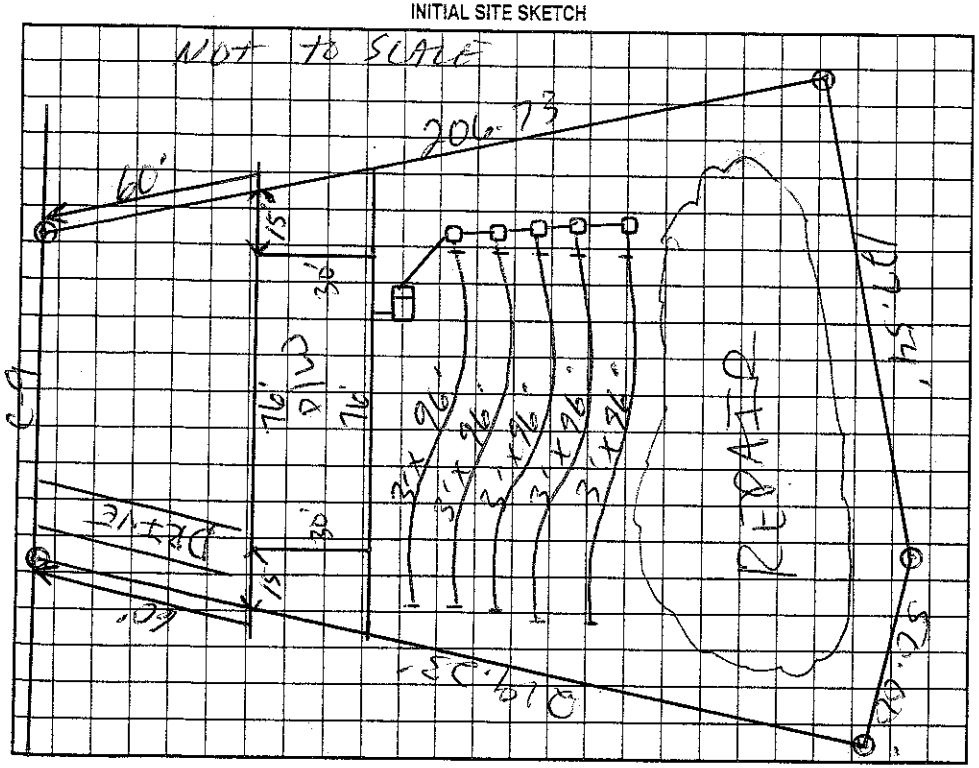

AS BUILT SKETCH

SYSTEM INSTALLED ACCORDING TO INITIAL SITE SKETCH

Permit can be suspended or revoked if any false information is supplied toward securing the permit/any unauthorized changes are made to the site/any unauthorized changes are made in the installation of the system. Improvement Permit with plat valid without expiration. Improvement Permit with site plan valid for sixty months. Authorization to Construct is valid for a period equal to that of Improvement Permit – not to exceed sixty months.

Signed: Chris Ethridge date 11/7/03

Improvement Permit by: [signature] date 11-5-03

Authorization to Construct by: [signature] date 11-5-03

Installed by: CRAIG THOMPSON

Operation Permit by: STEVE HENDRICK date 11-18-03

Existing System Inspection by: date

HEALTH DEPT. COPY: WHITE OWNER COPY (FINAL): YELLOW OWNER COPY (INITIAL): PINK