IREDELL COUNTY HEALTH DEPARTMENT

STATESVILLE 704-878-5305 (C1) MOORESVILLE 704-664-5281

IMPROVEMENT PERMIT / AUTHORIZATION TO CONSTRUCT / OPERATION PERMIT / EXISTING SYSTEM INSPECTION

PERMIT# 11537 PIN# 4850-00-1786 DATE 9-20-03

OWNER OR CONTRACTOR FLEETWOOD HOMES OF STATESVILLE PHONE: Business 704-400-7019 Home

ADDRESS 1270 NORTHSIDE DR STATESVILLE NC 28677

LOCATION 21 North, (L) JENNINGS (R) OLIN LOOP 1/2 mile on RT LOT # 15

SUBDIVISION OLIN GLEN BLOCK / SECTION 1 LOT 15 LOT AREA .5109 AC SITE CLASS. PS DESIGN FLOW 360 L.T.A.R. .25

Septic Tank: 1000 Gallons; STB 1012 Date 6-23-03
Pump Tank: Gallons; PT Date
Pump Make: Model Serial No.
Nitrification Field: No Fields 1 Square Feet 1440 Linear Feet 360'
No Lines 3 Trench Width 36" Max Trench Bottom Depth 18"

☒ New System ☐ Repair System Type: I, II, (III), IV, V, VI
System Description: GRN 25% RED
Repair System Description: LP PANEL
Maintenance Agreement Required: ☐ Yes ☒ No

☒ House/Mod. Home No. Bedrooms 3
☒ Mobile Home DW No. Bathrooms 2
☐ Business No. Employees
☐ Other


Gravel Depth N/A ☐ Slab ☒ Crawl Space ☐ Basement w/plumbing ☐ Basement wo/plumbing

Water Supply: ☐ Individual ☒ Public ☐ Community

Comments:/Conditions: (1) NOTE MAXIMUM TRENCH BOTTOM DEPTH OF 18" (2) INSTALL TRENCH DRAIN 30" DEEP, WITH 10" DIA TO BACK LEFT CORNER, THEN EXIT TO DAYLIGHT. (3) SYSTEM IS PLUMBED OUT COMPLETELY (4) MAINTAIN SETBACKS. Tuff-Tite Filter,

INITIAL SKETCH 1" = 50'

R = REPAIR

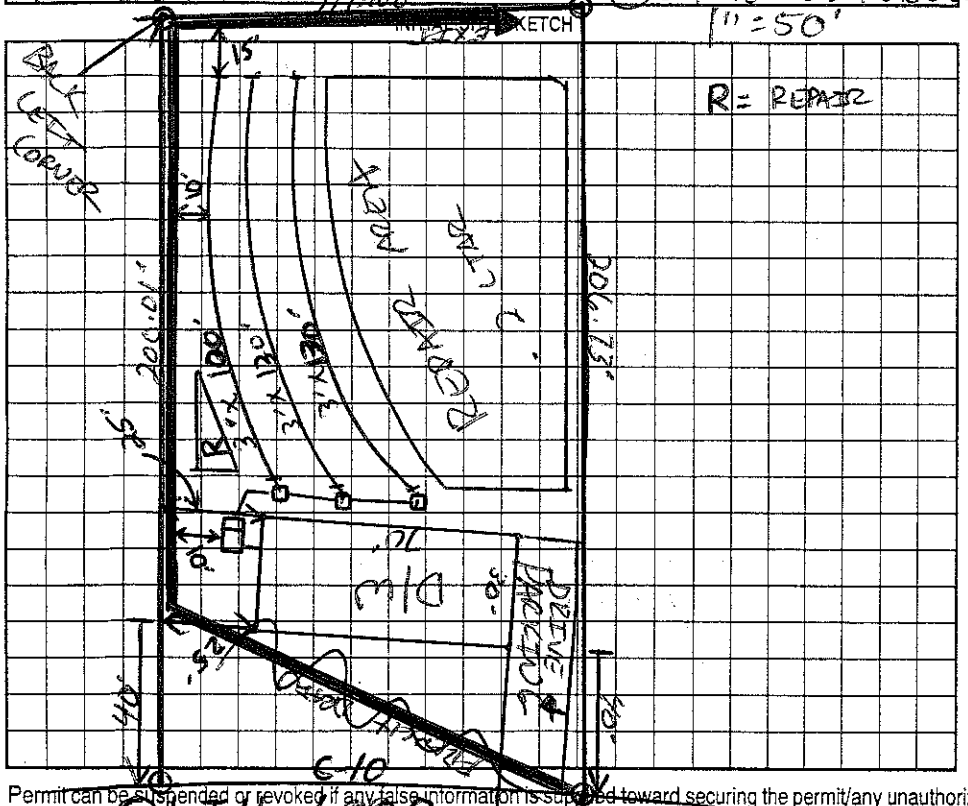

AS BUILT SKETCH

SYSTEM INSTALLED ACCORDING TO INITIAL SITE SKETCH

Permit can be suspended or revoked if any false information is supplied toward securing the permit/any unauthorized changes are made to the site/any unauthorized changes are made in the installation of the system. Improvement Permit with plat valid without expiration. Improvement Permit with site plan valid for sixty months. Authorization to Construct is valid for a period equal to that of Improvement Permit – not to exceed sixty months.

Signed: Brad Henderson date 10-3-03 Installed by: CRAIG THOMPSON

Improvement Permit by: [signature] date 9-20-03 Operation Permit by: STEVE HERRICK date 3-26-04

Authorization to Construct by: STEVE HERRICK date 10-3-03 Existing System Inspection by: date

HEALTH DEPT. COPY: WHITE OWNER COPY (FINAL): YELLOW OWNER COPY (INITIAL): PINK