IREDELL COUNTY HEALTH DEPARTMENT

STATESVILLE 704-878-5305 MOORESVILLE 704-664-5281

IMPROVEMENT PERMIT / AUTHORIZATION TO CONSTRUCT / OPERATION PERMIT / EXISTING SYSTEM INSPECTION

PERMIT# L50368 + L50903 PIN# 4850003616 / 4850-00-3616.11B DATE 5-28-08

OWNER OR APPLICANT Dixieland Inc. PHONE: Business 704 876 6162 Home

ADDRESS 116 & 118 Cora Ln.

LOCATION Hwy 21N, 1st on Jennings, right on Olin Rd, R on Cora, on right

SUBDIVISION Olin Ridge BLOCK / SECTION LOT 1 LOT AREA .6887 SITE CLASS PS DESIGN FLOW 240/240 L.T.A.R. 25

Septic Tank: 1000/1000 Gallons; STB 825/825 Date 6/20/08 6/16/08

Pump Tank: Gallons; PT Date

Pump Make: Model Serial No.

Nitrification Field: No Fields 2 Square Feet 1200/1200 Linear Feet 240/240

No Lines 6/6 Trench Width 36" Max Trench Bottom Depth 36" Gravel Depth

☒ New System ☐ Repair ☐ Expansion System Type: I II III IV V VI

System Description: 25% Reduction Gravity

Repair System Description: 50% Reduction LP Inc.

Maintenance Agreement Required: ☐ Yes ☒ No

☒ House/Mod. Home ☐ Mobile Home ☐ Business ☐ Other

No. Bedrooms 2/2 No. Persons No. Employees

Water Supply: ☒ Individual ☐ Public ☐ Community


☒ Gravity ☐ Pressure ☒ Slab ☐ Crawl Space ☐ Basement w/plumbing ☐ Basement wo/plumbing

Comments:/Conditions:

Comments:/Conditions:

2 Polylock Filter

INITIAL SITE SKETCH

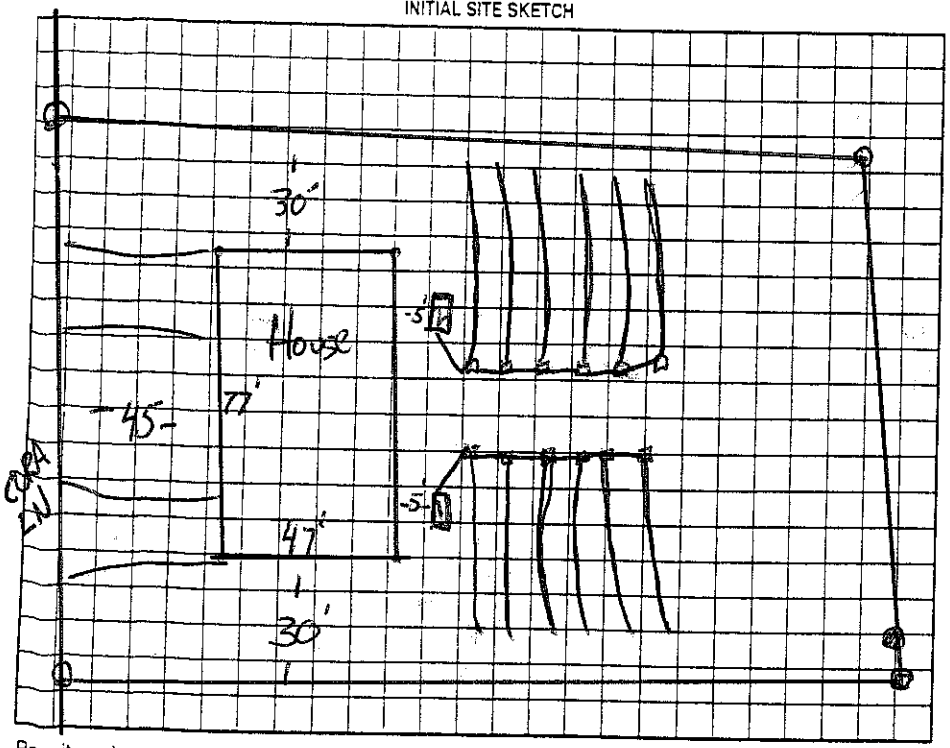

AS BUILT SKETCH

Permit can be suspended or revoked if any false information is supplied toward securing the permit/any unauthorized changes are made to the site/any unauthorized changes are made in the installation of the system. Improvement Permit with plat valid without expiration ☐ Improvement Permit with site plan valid for sixty months ☒ Authorization to Construct is valid for a period equal to that of Improvement Permit – not to exceed sixty months.

Signed: Lynna Dardle date 6/2/08

Improvement Permit by: date 5-28-08

Authorization to Construct by: date 5-28-08

Installed by: Rowan

Operation Permit by: date 8-12-08

Existing System Inspection by: date

HEALTH DEPT. COPY: WHITE OWNER COPY (FINAL): YELLOW OWNER COPY (INITIAL): PINK