IREDELL COUNTY HEALTH DEPARTMENT

STATESVILLE 704-878-5305 MOORESVILLE 704-664-5281

IMPROVEMENT PERMIT / AUTHORIZATION TO CONSTRUCT / OPERATION PERMIT / EXISTING SYSTEM INSPECTION

PERMIT# 123957 PIN# 4850-00-4828 DATE 10-22-04

OWNER OR CONTRACTOR RIVERGREEN, LLC PHONE: Business (704) 609-7745 Home

ADDRESS PO BOX 1732 LINCOLNTON NC 28093

LOCATION I-77N TR TOMLIN MILL TL JOSEY TL OLIN ON LEFT

SUBDIVISION OLIN GLEN BLOCK / SECTION 1 LOT 13 LOT AREA .4591 SITE CLASS. PS DESIGN FLOW 480 L.T.A.R. 0.3 GPD/FT²

Septic Tank: 1000 Gallons; STB 1012 Date 7-3-04
Pump Tank: Gallons; PT Date
Pump Make: Model Serial No.
Nitrification Field: No Fields 1 Square Feet 1600 Linear Feet 400
No Lines 5 Trench Width 36" Max Trench Bottom Depth 36" Gravel Depth N/A

☑ New System ☐ Repair System Type: I, II, (III), IV, V, VI
System Description: GRAVITY 25% REDUCTION
Repair System Description: LPP PPBPS 50% RED
Maintenance Agreement Required: ☐ Yes ☑ No

☐ House/Mod. Home No. Bedrooms 4
☑ Mobile Home No. Bathrooms
☐ Business No. Employees
☐ Other
☐ Slab ☑ Crawl Space ☐ Basement w/plumbing ☐ Basement wo/plumbing


Water Supply: ☐ Individual ☑ Public ☐ Community

Comments/Conditions: ① INSTALL LINES ON CONTOUR
② MAINTAIN SETBACKS

Comments/Conditions: ① YELLOW TUFF-TITE FILTER
② 6" RISER ③ INFILTRATOR CHAMBERS

(5) DROP BOXES

INITIAL SITE SKETCH 1" = 40'

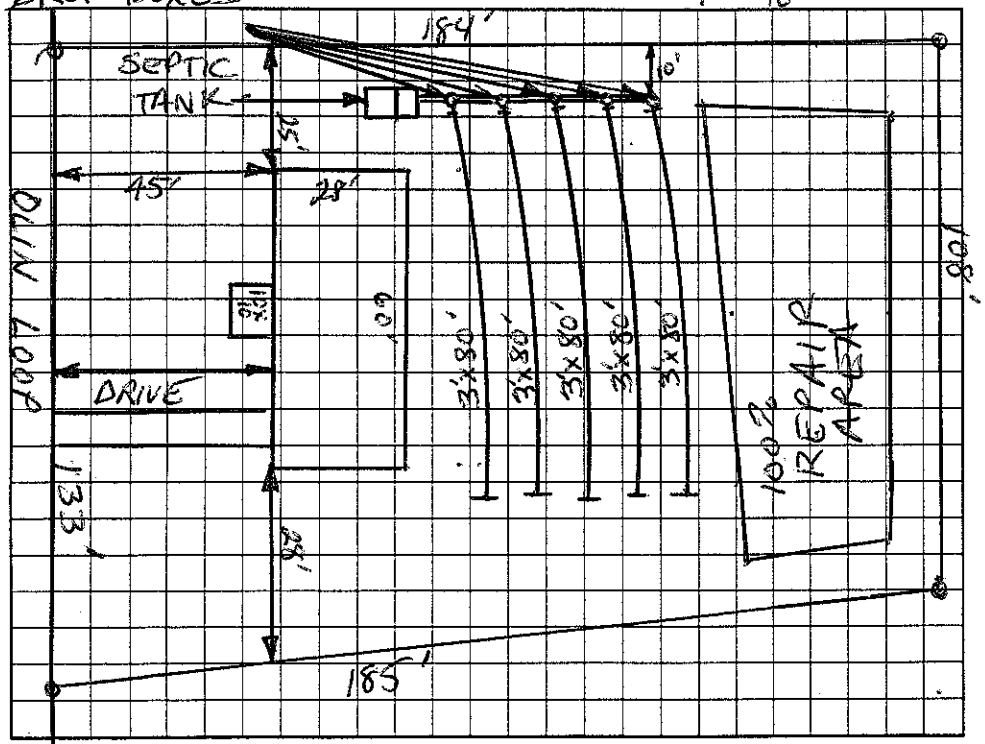

AS BUILT SKETCH

* INSTALLED AS SHOWN

Permit can be suspended or revoked if any false information is supplied toward securing the permit/any unauthorized changes are made to the site/any unauthorized changes are made in the installation of the system. Improvement Permit with plat valid without expiration. Improvement Permit with site plan valid for sixty months. Authorization to Construct is valid for a period equal to that of Improvement Permit – not to exceed sixty months.

Signed: date 12/10/04 Installed by: CRAIG THOMPSON

Improvement Permit by: Christopher M. Shemwell, PE date 10-22-04 Operation Permit by: Christopher M. Shemwell, PE date 12-30-04

Authorization to Construct by: Christopher M. Shemwell, PE date 12-10-04 Existing System Inspection by: date

HEALTH DEPT. COPY: WHITE OWNER COPY (FINAL): YELLOW OWNER COPY (INITIAL): PINK