IREDELL COUNTY HEALTH DEPARTMENT

STATESVILLE 704-878-5305 (Q) MOORESVILLE 704-664-5281

IMPROVEMENT PERMIT / AUTHORIZATION TO CONSTRUCT / OPERATION PERMIT / EXISTING SYSTEM INSPECTION

PERMIT# 1411283 PIN# 4850006500 11 DATE 2-6-07

OWNER OR APPLICANT Dixieland, Inc. PHONE: Business 704 202 4971 Home 704 876 6162

ADDRESS Cora Lane

LOCATION Hwy 21, Left on Jennings Rd, Right on Oli'n Loop, Right on Cora, Property on left.

SUBDIVISION Oli'n Ridge BLOCK / SECTION ____ LOT 18 LOT AREA .6934 SITE CLASS. PS DESIGN FLOW (320) x 2 L.T.A.R. .3

Septic Tank: 1000 x 2 Gallons; STB 825/825 Date 3-20-07/3-17-07

Pump Tank: ____ Gallons; PT ____ Date ____

Pump Make: ____ Model ____ Serial No. ____

Nitrification Field: No Fields 2 Square Feet 1200 each Linear Feet 300 each

No Lines 8(4 each Trench Width 36" Max Trench Bottom Depth 36" Gravel Depth n/a

☒ New System ☐ Repair ☐ Expansion System Type: I II III IV V VI

System Description: 25% Reduction

Repair System Description: 50% Reduction LP

Maintenance Agreement Required: ☐ Yes ☒ No

☒ House/Mod. Home No. Bedrooms 6

☐ Mobile Home No. Persons ____

☐ Business No. Employees ____

☒ Other (6 total) 3BR each/duplex


Water Supply: ☐ Individual ☐ Public ☒ Community

☒ Gravity ☐ Pressure ☒ Slab ☐ Crawl Space ☐ Basement w/plumbing ☐ Basement wo/plumbing

Comments:/Conditions:

Comments:/Conditions: SEPTIC TANKS W/ TAN MARKERS INSTALLED USING BLUE "INFITE" FILTER

INITIAL SITE SKETCH

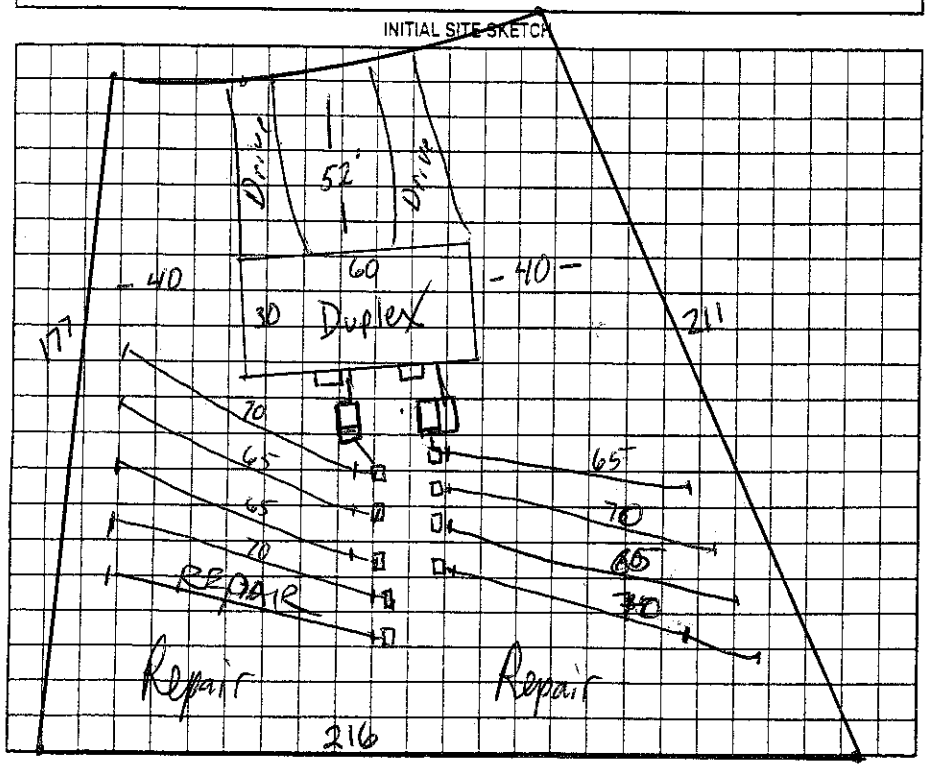

AS BUILT SKETCH

SYSTEM INSTALLED ACCORDING TO INITIAL SITE SKETCH USING 150 "QUICK-4" INFILTRATOR CHAMBERS

Permit can be suspended or revoked if any false information is supplied toward securing the permit/any unauthorized changes are made to the site/any unauthorized changes are made in the installation of the system. Improvement Permit with plat valid without expiration ☐ Improvement Permit with site plan valid for sixty months ☒ Authorization to Construct is valid for a period equal to that of Improvement Permit – not to exceed sixty months.

Signed: Ginger Dowdle date 2-7-07

Improvement Permit by: ____ date 2-6-07

Authorization to Construct by: ____ date 2-6-07

Installed by: Brian Septic

Operation Permit by: Steve Hedrick date 5-7-07

Existing System Inspection by: ____ date ____

HEALTH DEPT. COPY: WHITE OWNER COPY (FINAL): YELLOW OWNER COPY (INITIAL): PINK