IREDELL COUNTY HEALTH DEPARTMENT

STATESVILLE 704-878-5305 MOORESVILLE 704-664-5281

IMPROVEMENT PERMIT / AUTHORIZATION TO CONSTRUCT / OPERATION PERMIT / EXISTING SYSTEM INSPECTION

PERMIT# 81049 PIN# 4850 06 0768 DATE 5-13-99

OWNER OR CONTRACTOR Jamie Gilbert PHONE: Business Home 704 483 0728

ADDRESS 2304 Beth Haven church Rd Denver N.C.

LOCATION I-77 N TO Tomlin mill TR Jennings TR Red Hawk 1.5 mile

SUBDIVISION Glenn AC BLOCK / SECTION LOT 18 LOT AREA 2.18 acres SITE CLASS DESIGN FLOW 480 L.T.A.R. .3

Septic Tank: 1000 Gallons; STB 760 Date 7-28-00
Pump Tank: Gallons; PT Date
Pump Make: Model Serial No.
Nitrification Field: No Fields 1 Square Feet 1600 Linear Feet 533
No Lines 5 Trench Width 36" Max Trench Bottom Depth 36" Gravel Depth 12"

☑ New System ☐ Repair System Type: I ☒ III, IV, V, VI
System Description: Conv. Gravity
Repair System Description:
Maintenance Agreement Required: ☐ Yes ☑ No
☐ Slab ☐ Crawl Space ☑ Basement w/plumbing ☐ Basement wo/plumbing


☑ House/Mod. Home No. Bedrooms 4
☐ Mobile Home No. Bathrooms 3.5
☐ Business No. Employees
☐ Other

Water Supply:
☐ Individual
☐ Public
☐ Community

Comments/Conditions: 3201

Comments/Conditions: SEPTIC TANK WITH MARKER INSTALLED USING "ZABEL" FILTER

INITIAL SITE SKETCH

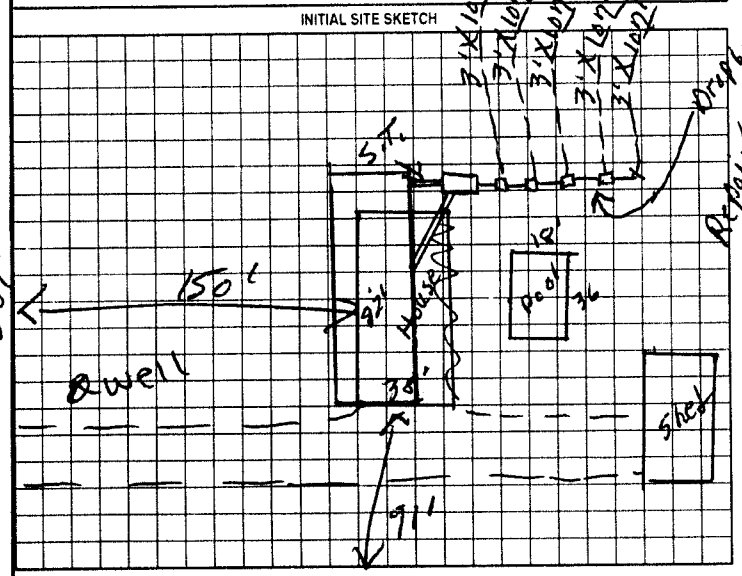

AS BUILT SKETCH

AS SHOWN

Permit can be suspended or revoked if any false information is supplied toward securing the permit/any unauthorized changes are made to the site/any unauthorized changes are made in the installation of the system. Improvement Permit with plat valid without expiration. Improvement Permit with site plan valid for sixty months. Authorization to Construct is valid for a period equal to that of Improvement Permit - not to exceed sixty months.

Signed: [signature] date Installed by: DONALD LAKEY

Improvement Permit by: R. C. Moore date 5-13-99 Operation Permit by: STEVE HENDRICK date 12-5-00

Authorization to Construct by: R. C. Moore date 5-13-99 Existing System Inspection by: date

HEALTH DEPT COPY WHITE OWNER COPY (FINAL) YELLOW OWNER COPY (INITIAL) PINK