IREDELL COUNTY HEALTH DEPARTMENT

STATESVILLE 704-878-5305 (C1) MOORESVILLE 704-664-5281

IMPROVEMENT PERMIT / AUTHORIZATION TO CONSTRUCT / OPERATION PERMIT / EXISTING SYSTEM INSPECTION

PERMIT# 108105 PIN# 4850-06-3301 DATE 8.13.02

OWNER OR CONTRACTOR VONDA EKLUND PHONE: Business Home 704-924-8542

ADDRESS 128 ROBBINETTE ROAD, STATESVILLE, NC 28625

LOCATION US 21N, TL JENNINGS ROAD, TR RED HAWK LANE, LOT # 4 ON RIGHT

SUBDIVISION GLEN ACRES BLOCK / SECTION LOT 4 LOT AREA 1.750 ACRES SITE CLASS PS DESIGN FLOW 480 L.T.A.R. 0.40 GPD/FT²

Septic Tank: 1000 Gallons: STB 354 Date 11-28-01
Pump Tank: Gallons: PT Date
Pump Make: Model Serial No
Nitrification Field: No Fields Square Feet 1200 Linear Feet 300
No Lines FOUR Trench Width 36" Max Trench Bottom Depth 36" Gravel Depth N/A

New System ☐ Repair System Type: I II III IV V
System Description: 25% REDUCTION, GRAVITY
Repair System Description: 25% REDUCTION, PUMP
Maintenance Agreement Required: ☐ Yes ☑ No


House/Mod Home No. Bedrooms 4
Mobile Home No. Bathrooms 3
Business No. Employees
Other
☐ Slab ☑ Crawl Space ☐ Basement w/plumbing ☐ Basement wo/plumbing

Water Supply: ☑ Individual ☐ Public ☐ Community
WELL


Comments/Conditions: REMOVE EXISTING FIELD TERRACE IN VICINITY OF DRAINFIELD & INSTALL 25% REDUCTION SYSTEM IN FOUR EQUAL LENGTH LINES ON CONTOUR, AS FLAGGED

Comments/Conditions: SEPTIC TANK W/ MARKER INSTALLED USING "POLYLOK" FILTER

INITIAL SITE SKETCH

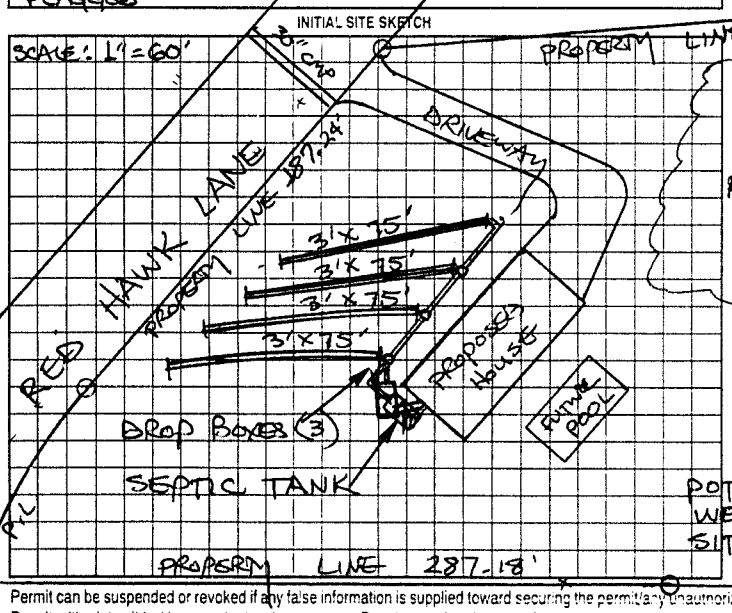

AS BUILT SKETCH

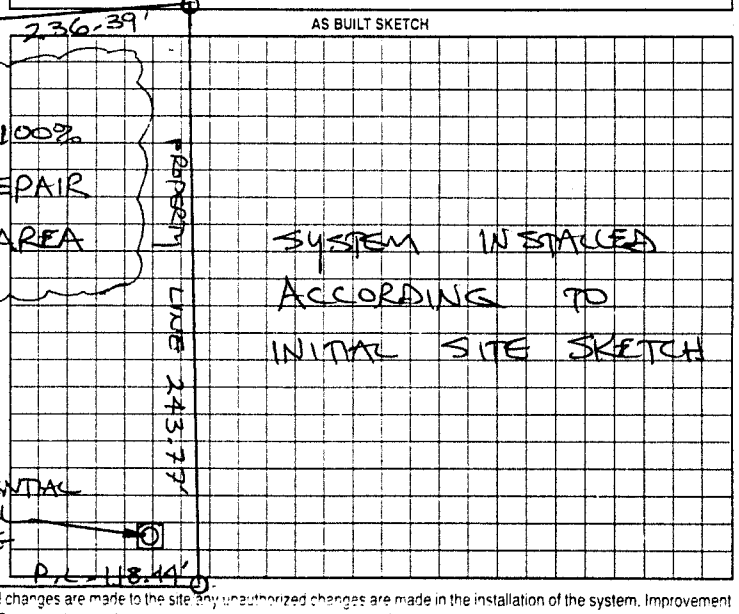

Permit can be suspended or revoked if any false information is supplied toward securing the permit/any unauthorized changes are made to the site/any unauthorized changes are made in the installation of the system. Improvement Permit with plat valid without expiration. Improvement Permit with site plan valid for sixty months. Authorization to Construct is valid for a period equal to that of Improvement Permit - not to exceed sixty months

Signed: Vonda Eklund date 8-14-02 Installed by: G & M ENTERPRISES

Improvement Permit by: STEVE HEDRICK date 8-13-02 Operation Permit by STEVE HEDRICK date 9-30-02

Authorization to Construct by: STEVE HEDRICK date 8-13-02 Existing System Inspection by: date

HEALTH DEPT COPY WHITE OWNER COPY (FINAL) YELLOW OWNER COPY (INITIAL) PINK