IREDELL COUNTY HEALTH DEPARTMENT

STATESVILLE 704-878-5305 MOORESVILLE 704-664-5281

IMPROVEMENT PERMIT / AUTHORIZATION TO CONSTRUCT / OPERATION PERMIT / EXISTING SYSTEM INSPECTION

PERMIT# 106609 PIN# 4850-06-5817 DATE 6-5-02

OWNER OR CONTRACTOR JERRY ROBERTS PHONE Business 704-878-3567 (COMM) Home 704-528-4288

ADDRESS 151 CARRIGAN ROAD, TROUTMAN, NC 28166

LOCATION US 21 N, TL JENNINGS RD, TR RED HAWK LANE, 3RD LOT ON LEFT 200' BACK OFF ROAD

SUBDIVISION GLENN ACRES BLOCK / SECTION ____ LOT 15 LOT AREA 3.797 ACRES SITE CLASS PS DESIGN FLOW 360 L.T.A.R. 0.30 GPD/FT²

Septic Tank: 1000 Gallons: STB 1007 Date 7-1-01
Pump Tank: ____ Gallons: PT ____ Date ____
Pump Make: ____ Model ____ Serial No ____
Nitrification Field: No Fields 1 Square Feet 1200 Linear Feet 400
No Lines FOUR Trench Width 36" Max Trench Bottom Depth 36" Gravel Depth 12"

☑ New System ☐ Repair System Type: I (II) III IV V VI
System Description: CONVENTIONAL, GRAVITY
Repair System Description: CONVENTIONAL, GRAVITY
Maintenance Agreement Required: Yes ☑ No
☐ Slab ☑ Crawl Space ☐ Basement w/plumbing ☐ Basement wo/plumbing


☑ House/Mod. Home No. Bedrooms 3
☐ Mobile Home No. Bathrooms 2
☐ Business No. Employees ____
☐ Other ____

Water Supply:
☑ Individual
☐ Public
☐ Community
WELL

Comments/Conditions: ① INSTALL SUBSURFACE INTERCEPT DRAINAGE DITCH AS SHOWN BEGINNING 48" DEEP OUT TO DAYLIGHT
② KEEP SYSTEM MINIMUM 100 FEET FROM WELL

Comments/Conditions: SEPTIC TANK WITH MARKER INSTALLED USING "POLYLOK" FILTER

INITIAL SITE SKETCH

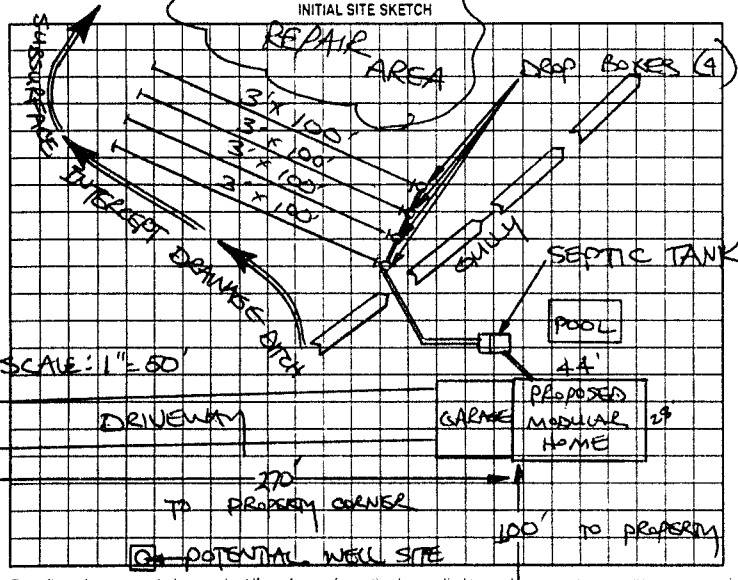

AS BUILT SKETCH

SYSTEM INSTALLED ACCORDING TO INITIAL SITE SKETCH

Permit can be suspended or revoked if any false information is supplied toward securing the permit, any unauthorized changes are made to the site, any unauthorized changes are made in the installation of the system. Improvement Permit with plat valid without expiration. Improvement Permit with site plan valid for sixty months. Authorization to Construct is valid for a period equal to that of Improvement Permit – not to exceed sixty months.

Signed: Debra D. Roberts date 6/5/02 installed by STATESVILLE BACKHOE

Improvement Permit by: STEVE HEDRICK date 6-5-02 Operation Permit by STEVE HEDRICK date 8-23-02

Authorization to Construct by: STEVE HEDRICK date 6-5-02 Existing System Inspection by: ____ date ____

HEALTH DEPT COPY: WHITE OWNER COPY (FINAL): YELLOW OWNER COPY (INITIAL): PINK