IREDELL COUNTY HEALTH DEPARTMENT

STATESVILLE 704-878-5305 CI MOORESVILLE 704-664-5281

IMPROVEMENT PERMIT / AUTHORIZATION TO CONSTRUCT / OPERATION PERMIT / EXISTING SYSTEM INSPECTION

PERMIT# 106783 PIN# 4850-06-6499 DATE 6-11-02

OWNER OR CONTRACTOR RICK HONEYCUTT PHONE: Business Home 704-539-4723

ADDRESS 873 EUPEPTIC SPRINGS RD, OLIN NC 28660

LOCATION US 21 N, TL JENNINGS RD, TR RED HAWK LANE, LOT # 13 ON LEFT IN CURVE

SUBDIVISION GLEN ACRES BLOCK / SECTION LOT 13 LOT AREA 3.01 ACRES SITE CLASS. PS DESIGN FLOW 480 L.T.A.R. 0.30 GPD/FT²

Septic Tank: 1000 Gallons; STB 760 Date 4-17-06

Pump Tank: Gallons; PT Date

Pump Make: Model Serial No.

Nitrification Field: No Fields 1 Square Feet 1600 Linear Feet 533

No Lines FOUR Trench Width 36" Max Trench Bottom Depth 36" Gravel Depth 12"

☑ New System ☐ Repair System Type: I, II, III, IV, V, VI

System Description: CONVENTIONAL, GRAVITY

Repair System Description: CONVENTIONAL, GRAVITY

Maintenance Agreement Required: ☐ Yes ☑ No

☑ House/Mod. Home No. Bedrooms 4

☐ Mobile Home No. Bathrooms 3

☐ Business No. Employees

☐ Other


☐ Slab ☑ Crawl Space ~~☐ Basement w/plumbing~~ ☐ Basement wo/plumbing

Water Supply: ☑ Individual ☐ Public ☐ Community WELL


Comments:/Conditions: KEEP SYSTEM MINIMUM 100 FEET FROM WELL

Comments:/Conditions: Red Polylock filter; no risers; no S/T mark

INITIAL SITE SKETCH

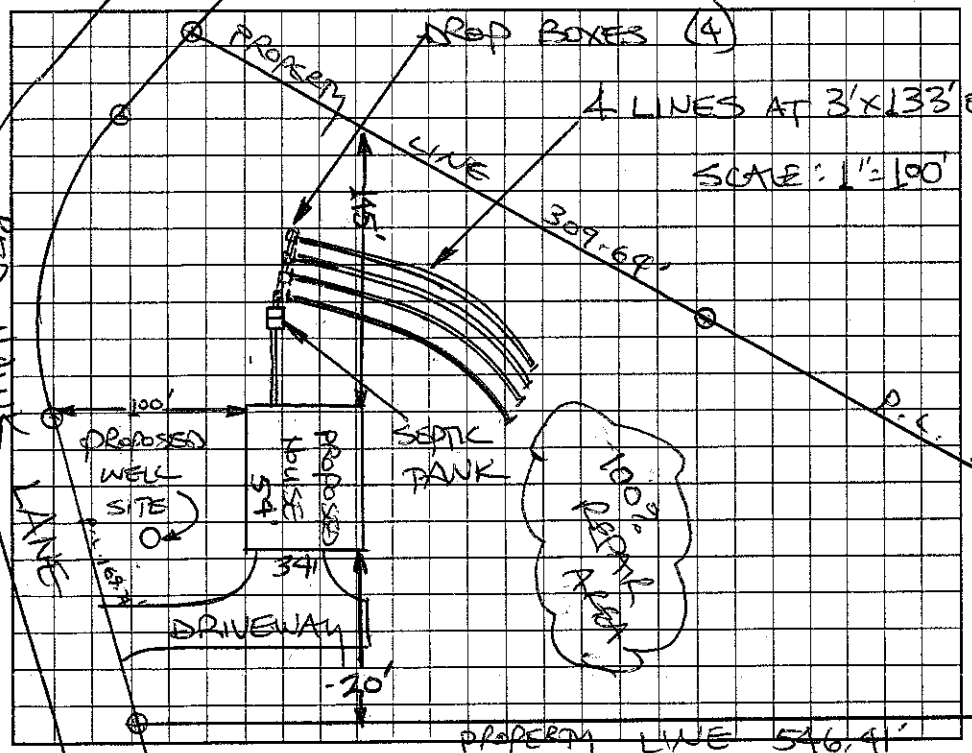

AS BUILT SKETCH

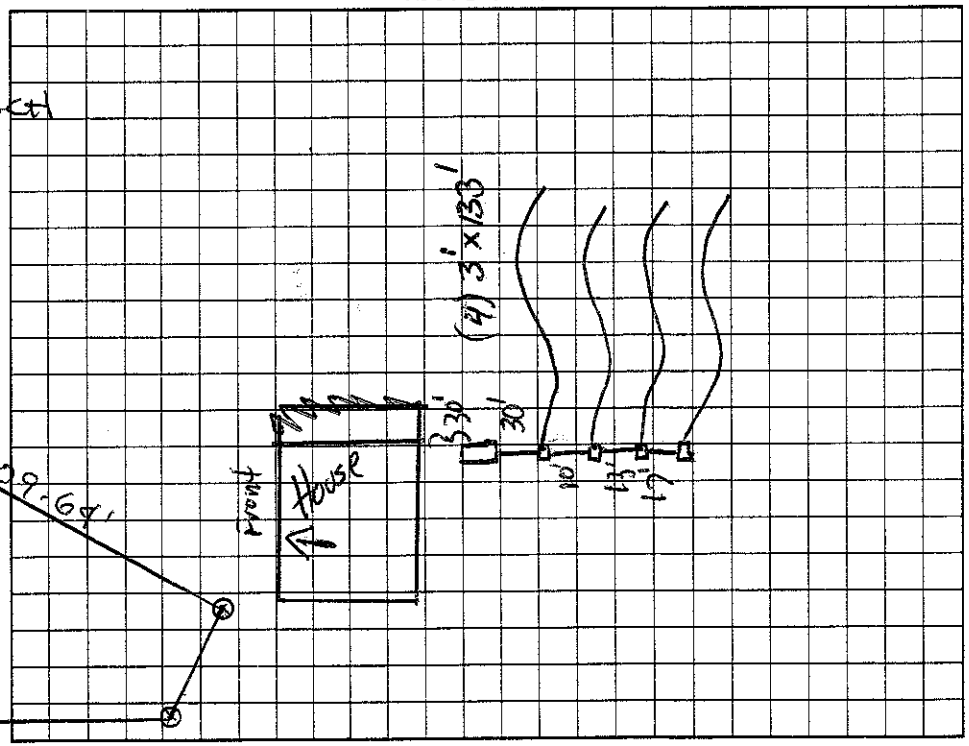

Permit can be suspended or revoked if any false information is supplied toward securing the permit/any unauthorized changes are made to the site/any unauthorized changes are made in the installation of the system. Improvement Permit with plat valid without expiration. Improvement Permit with site plan valid for sixty months. Authorization to Construct is valid for a period equal to that of Improvement Permit – not to exceed sixty months.

Signed: Rick Honeycutt date 6-11-02

Improvement Permit by: STEVE HEDRICK date 6-11-02

Authorization to Construct by: STEVE HEDRICK date 6-11-02

Installed by: Sammy Rewis

Operation Permit by: James Lewis date 9-8-06

Existing System Inspection by: date

HEALTH DEPT. COPY: WHITE OWNER COPY (FINAL): YELLOW OWNER COPY (INITIAL): PINK