IREDELL COUNTY HEALTH DEPARTMENT

STATESVILLE 704-878-5305 MOORESVILLE 704-664-5281

IMPROVEMENT PERMIT / AUTHORIZATION TO CONSTRUCT / OPERATION PERMIT / EXISTING SYSTEM INSPECTION

PERMIT# 88968 PIN# 4850067044 DATE 5/10/00

OWNER OR CONTRACTOR DAVID STUART PHONE: Business _____ Home 539-5135

ADDRESS 148 SEMPER FIDELIS RD. OLIN NC 28660

LOCATION TOMLIN MILL - TR JENNINGS - TR RED HAWK - AT END ON RT

SUBDIVISION GLENN ACRES BLOCK / SECTION _____ LOT 6 LOT AREA 2.44C SITE CLASS PS DESIGN FLOW 360gpd L.T.A.R. 360/432

Septic Tank: 1000 Gallons; STB 620 Date 5-2000

Pump Tank: _____ Gallons; PT _____ Date _____

Pump Make: _____ Model _____ Serial No. _____

Nitrification Field: No Fields 1 Square Feet 1200 Linear Feet 400

No Lines 4@100' Trench Width 36" Max Trench Bottom Depth 36" Gravel Depth 12"

☑ New System ☐ Repair System Type: I (II) III IV V VI

System Description: GRAVITY CONVENTIONAL

Repair System Description: SAME

Maintenance Agreement Required: ☐ Yes ☑ No

☑ House/Mod. Home No. Bedrooms 3

☑ Mobile Home No. Bathrooms 2

☐ Business No. Employees _____

☐ Other _____


☐ Slab ☑ Crawl Space ☐ Basement w/plumbing ☐ Basement wo/plumbing

Water Supply: ☑ Individual ☐ Public ☐ Community


Comments/Conditions:

Comments/Conditions:

INITIAL SITE SKETCH 1" = 100'

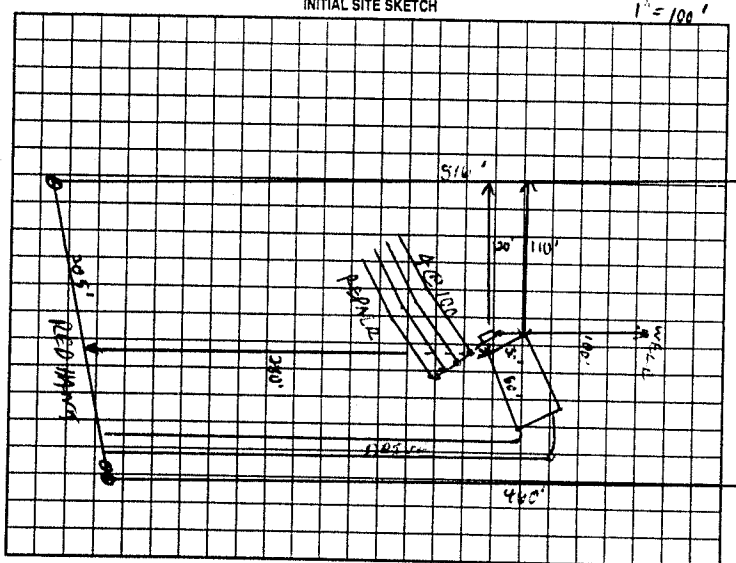

AS BUILT SKETCH

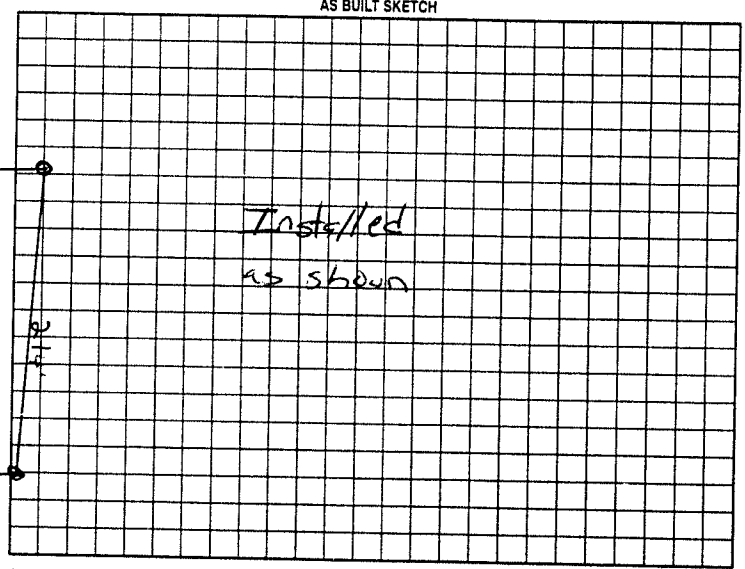

Permit can be suspended or revoked if any false information is supplied toward securing the permit/any unauthorized changes are made to the site/any unauthorized changes are made in the installation of the system. Improvement Permit with plat valid without expiration. Improvement Permit with site plan valid for sixty months. Authorization to Construct is valid for a period equal to that of Improvement Permit – not to exceed sixty months.

Signed: David Stuart date 5/10/00

Improvement Permit by: C. Lyon RS date 5/10/00

Authorization to Construct by: C. Lyon RS date 5/10/00

Installed by: Kenny Madison

Operation Permit by: M. Cox date 6-13-00

Existing System Inspection by: _____ date _____

HEALTH DEPT. COPY: WHITE OWNER COPY (FINAL) YELLOW OWNER COPY (INITIAL): PINK