IREDELL COUNTY HEALTH DEPARTMENT

STATESVILLE 704-878-5305 (CL) MOORESVILLE 704-664-5281

IMPROVEMENT PERMIT / AUTHORIZATION TO CONSTRUCT / OPERATION PERMIT / EXISTING SYSTEM INSPECTION

(V)

PERMIT# 105376 PIN# 4850 06 9073 DATE 4-1-02

OWNER OR CONTRACTOR PHILAS L. EUDY PHONE: Business Home 704-788-4665

ADDRESS 5150 ZION CHURCH ROAD CONCORD, NC 28025

LOCATION US 21 N TO JENNINGS ROAD TR RED HAWK LANE, LOT # 7 ON RIGHT

SUBDIVISION GLEN ACRES BLOCK / SECTION LOT 7 LOT AREA 2.999 ACRES SITE CLASS. PS DESIGN FLOW 360 L.T.A.R. 0.40 GPD/FT²

Septic Tank: 1000 Gallons; STB 1007 Date 1-13-03
Pump Tank: Gallons; PT Date
Pump Make: Model Serial No.
Nitrification Field: No Fields 1 Square Feet 900 Linear Feet 300
No Lines FOUR Trench Width 36" Max Trench Bottom Depth 36" Gravel Depth 12"

☑ New System ☐ Repair System Type: I (II) III, IV, V, VI
System Description: CONVENTIONAL, GRAVITY
Repair System Description: CONVENTIONAL, GRAVITY
Maintenance Agreement Required: ☐ Yes ☑ No
☐ Slab ☑ Crawl Space ☐ Basement w/plumbing ☐ Basement wo/plumbing


☑ House/Mod. Home No. Bedrooms 3
☐ Mobile Home No. Bathrooms 2
☐ Business No. Employees
☐ Other

Water Supply: ☑ Individual ☐ Public ☐ Community
WELL


Comments:/Conditions: KEEP SYSTEM MINIMUM 100 FEET FROM WELL

Comments:/Conditions: (1) NO FILL DIRT ALLOWED OVER SYSTEM (2) REMOVE EXISTING FIELD TERRACE (3) SEPTIC TANK WITH MARKER INSTALLED USING "POLYLOK" FILTER (3) SYSTEM ALTERED WITH PRIOR APPROVAL

INITIAL SITE SKETCH

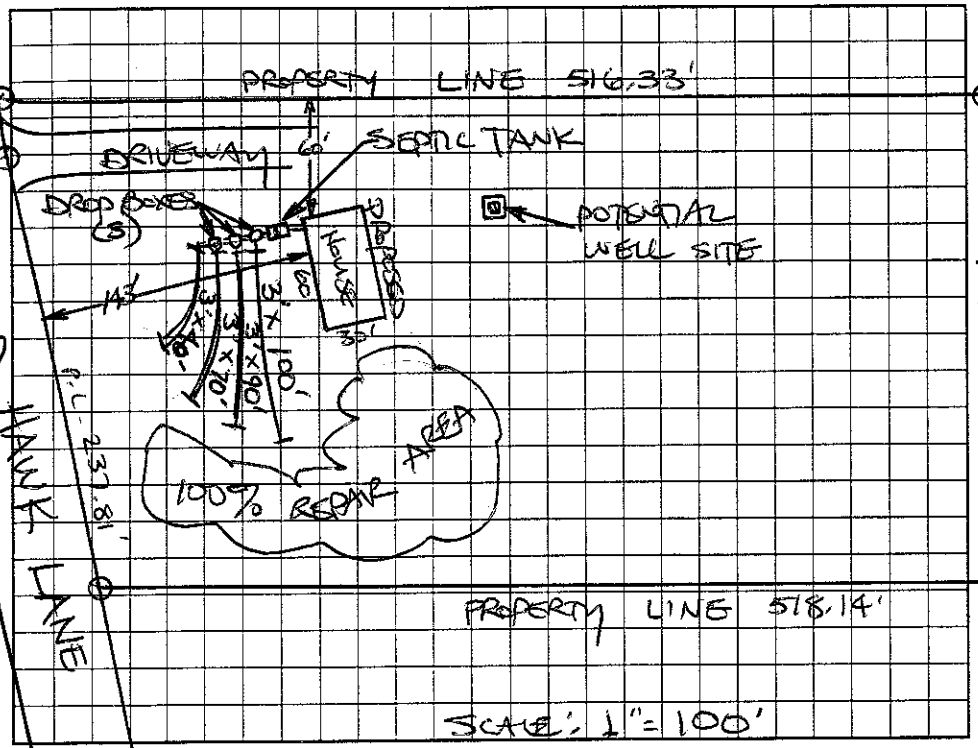

AS BUILT SKETCH

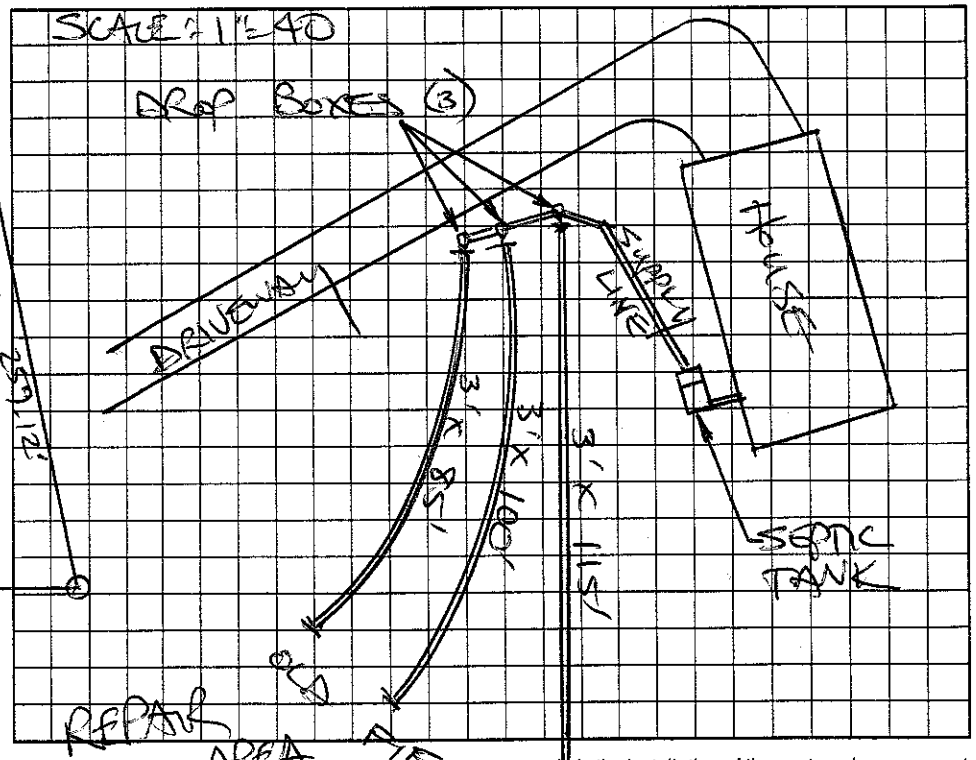

Permit can be suspended or revoked if any false information is supplied toward securing the permit/any unauthorized changes are made to the site/any unauthorized changes are made in the installation of the system. Improvement Permit with plat valid without expiration. Improvement Permit with site plan valid for sixty months. Authorization to Construct is valid for a period equal to that of Improvement Permit, not to exceed sixty months.

Signed: P.L. Eudy date 4-1-02 Installed by: BILL ADAMS

Improvement Permit by: STEVE HEDRICK date 4-1-02 Operation Permit by: STEVE HEDRICK date 3-14-03

Authorization to Construct by: STEVE HEDRICK date 4-1-02 Existing System Inspection by: date

HEALTH DEPT. COPY: WHITE OWNER COPY (FINAL): YELLOW OWNER COPY (INITIAL): PINK