IREDELL COUNTY HEALTH DEPARTMENT

STATESVILLE 704-878-5305 (C1) MOORESVILLE 704-664-5281

IMPROVEMENT PERMIT / AUTHORIZATION TO CONSTRUCT / OPERATION PERMIT / EXISTING SYSTEM INSPECTION

(C1)

PERMIT# 109155 PIN# 4850-32-3507 DATE 10-28-02

OWNER OR CONTRACTOR CALVIN YORK PHONE. Business Home 704-876-2665

ADDRESS 417 OLIN LOOP ROAD, OLIN NC 28660

LOCATION I-77N, TR TOMLIN MILL ROAD, TL JOSEY RD, TR OLIN LOOP RD, 2ND DRIVE ON LEFT

SUBDIVISION BLOCK / SECTION LOT LOT AREA 3.56 ACRES SITE CLASS PS DESIGN FLOW 100 L.T.A.R. 0.30 GPD/FT

Septic Tank: 1000 Gallons: STB 1012 Date 6-29-02
Pump Tank: Gallons: PT Date
Pump Make: Model Serial No.
Nitrification Field: No Fields 1 Square Feet 333 Linear Feet 115
No Lines TWO Trench Width 36" Max Trench Bottom Depth 36" Gravel Depth 12"

☑ New System ☐ Repair System Type: I (II) III IV V VI
System Description: CONVENTIONAL, GRAVITY
Repair System Description: CONVENTIONAL, GRAVITY
Maintenance Agreement Required: ☐ Yes ☐ No
☑ Slab ☐ Crawl Space ☐ Basement w/plumbing ☐ Basement wo/plumbing


☐ House/Mod. Home No. Bedrooms
☐ Mobile Home No. Bathrooms 1
☐ Business No. Employees
☑ Other PRIVATE SHOP

Water Supply: ☑ Individual ☐ Public ☐ Community WELL

Comments/Conditions: USE SCHEDULE 80 PVC BENEATH AREA SUBJECT TO VEHICULAR TRAFFIC

Comments/Conditions ① SEPTIC TANK WITH MARKER INSTALLED USING "TUFTITE" FILTER ② SEPTIC SYSTEM INSTALLED DURING PERIOD OF WET SOIL CONDITIONS

INITIAL SITE SKETCH

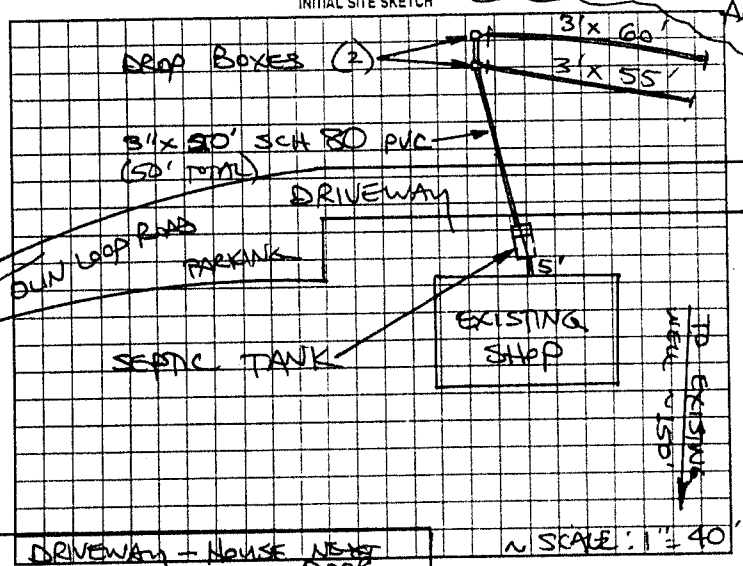

AS BUILT SKETCH

SYSTEM INSTALLED ACCORDING TO INITIAL SITE SKETCH

Permit can be suspended or revoked if any false information is supplied toward securing the permit; any unauthorized changes are made to the site; any unauthorized changes are made in the installation of the system. Improvement Permit with plat valid without expiration. Improvement Permit with site plan valid for sixty months. Authorization to Construct is valid for a period equal to that of Improvement Permit – not to exceed sixty months.

Signed: + Calvin A York date 10-28-02 Installed by: STEVE JORDAN

Improvement Permit by: STEVE HENDRICK date 10-28-02 Operation Permit by: STEVE HENDRICK date 12-18-02

Authorization to Construct by: STEVE HENDRICK date 10-28-02 Existing System Inspection by: date

HEALTH DEPT COPY WHITE OWNER COPY (FINAL) YELLOW OWNER COPY (INITIAL) PINK