IREDELL COUNTY HEALTH DEPARTMENT

STATESVILLE 704-878-5305 (R) MOORESVILLE 704-664-5281 (R)

IMPROVEMENT PERMIT / AUTHORIZATION TO CONSTRUCT / OPERATION PERMIT / EXISTING SYSTEM INSPECTION

PERMIT # 159088 PIN # 4850565063 DATE 11/18/09

OWNER or APPLICANT Kenneth & Jill Speece PHONE: Business 704 483-3702 Home:

OWNER or APPLICANT ADDRESS 6030 Olin Loop

LOCATION / DIRECTIONS To Jennings Rd, (R) on Olin Lp, on (R)

SUBDIVISION ~~Non~~ Speece Family 50 BLOCK / SECTION n/a LOT # ~~Non~~ 2 LOT AREA .72 DESIGN FLOW 360 L.T.A.R. .3

Septic Tank 1000 Gallons: STB Date

Pump Tank Gallons: P T Date

Pump Make Model Serial #

Nitrification Field No Fields 1 No Lines 3 Linear Feet 300

Trench Width 36" Max. Trench Bottom Depth 36" Gravel Depth n/a

☒ New System ☐ Repair ☐ Expansion System Type I (II) III IV V VI

System Description: 25% Reduction

Repair System Description: 50% Reduction (pump, flow)

Maintenance Agreement Required ☐ YES ☒ NO

☒ GRAVITY ☐ PRESSURE

☒ Residence No. Bedrooms 3

☐ Business No. Persons

☐ Other No. Employees

☐ Slab ☒ Crawl Space


☐ Basement w/plumbing ☐ Basement w/o plumbing

Water Supply: ☐ Private ☒ Public ☐ Community

Comments / Conditions

Comments / Conditions

INITIAL SITE SKETCH

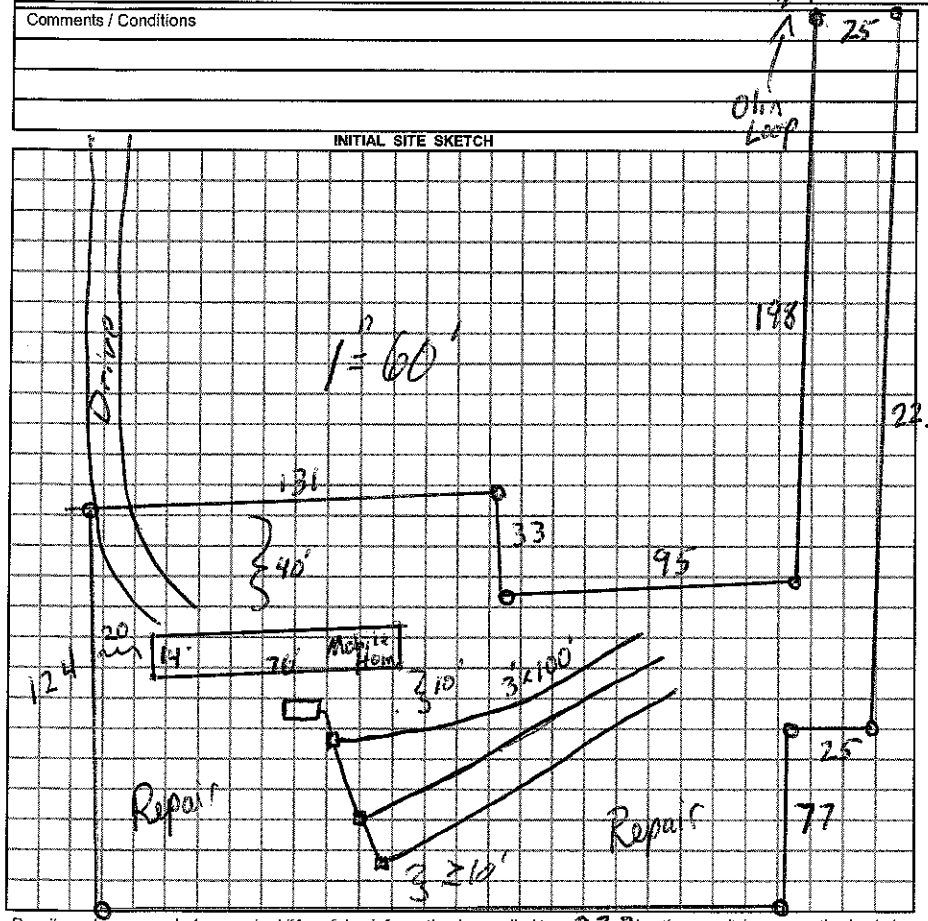

AS BUILT SKETCH

Permit can be suspended or revoked if any false information is supplied toward obtaining the permit / any unauthorized changes are made to the site / any unauthorized changes are made in the installation of the system.

☐ *IMPROVEMENT PERMIT w / plat valid without expiration.* ☒ *IMPROVEMENT PERMIT w / site plan valid for 60 mos.* ☒ *AUTHORIZATION TO CONSTRUCT valid for period equal to IMPROVEMENT PERMIT-not to exceed 60 mo.*

Owner / Applicant Signature: Kenneth Speece Date 11-18-09

Improvement Permit by: James Date 11-18-9

Authorization to Construct by: James Date 11-18-9

Installed by: Able Grading

Operation Permit by: James Date: 12-10-9

Existing System Inspected by: Date:

YOU SHOULD CONTACT A LOCATOR SERVICE PRIOR TO ANY EXCAVATION.

WHITE COPY Environmental Health YELLOW COPY (Final) Owner / Applicant PINK COPY (Initial) Owner / Applicant