IREDELL COUNTY HEALTH DEPARTMENT

STATESVILLE 704-878-5305 MOORESVILLE 704-664-5281

CI

IMPROVEMENT PERMIT / AUTHORIZATION TO CONSTRUCT / OPERATION PERMIT / EXISTING SYSTEM INSPECTION

PERMIT# 109268 PIN# 4850-56-~~5745~~ 5166 DATE 10-22-02

OWNER OR CONTRACTOR KEN SPEECE PHONE: Business Home 704-876-3639

ADDRESS 628 OLIN LOOP, OLIN, NC 28660

LOCATION I-77 N, TR TOMLIN MILL RD, TL JOSEY ROAD TR OLIN LOOP ROAD, 1.1 MILE ON RIGHT

SUBDIVISION BLOCK / SECTION LOT LOT AREA 173' x 297' SITE CLASS PS DESIGN FLOW 360 L.T.A.R. 0.40 GPD/FT²

Septic Tank: 1000 Gallons; STB 794 Date 4-17-03

Pump Tank: Gallons; PT Date

Pump Make: Model Serial No.

Nitrification Field: No Fields 1 Square Feet 900 Linear Feet 300

No Lines THREE Trench Width 36" Max Trench Bottom Depth 36" Gravel Depth 12"

☑ New System ☐ Repair System Type: I, II, III, IV, V, VI

System Description: CONVENTIONAL, GRAVITY

Repair System Description: CONVENTIONAL, GRAVITY

Maintenance Agreement Required: ☐ Yes ☑ No

☐ House/Mod. Home ☑ Mobile Home ☐ Business ☐ Other

No. Bedrooms 2 No. Bathrooms 2 No. Employees


Water Supply: ☐ Individual ☑ Public ☐ Community

☐ Slab ☑ Crawl Space ☐ Basement w/plumbing ☐ Basement wo/plumbing


Comments/Conditions: ZABEL FILTER & MARKER INSTALLED AS DRAWN

Comments/Conditions:

INITIAL SITE SKETCH

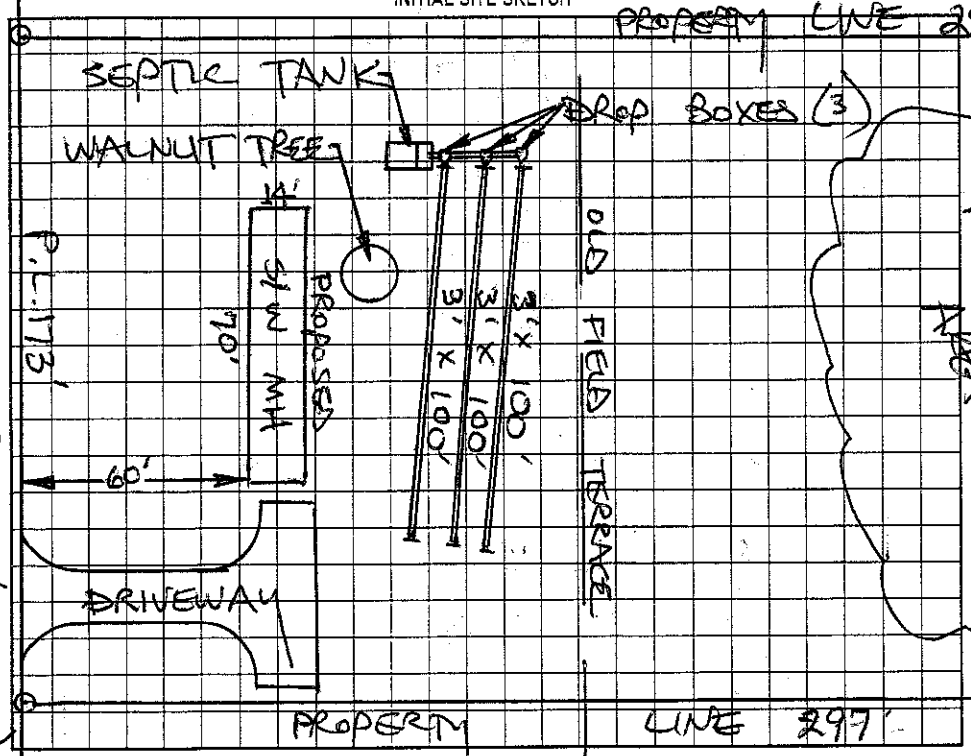

AS BUILT SKETCH

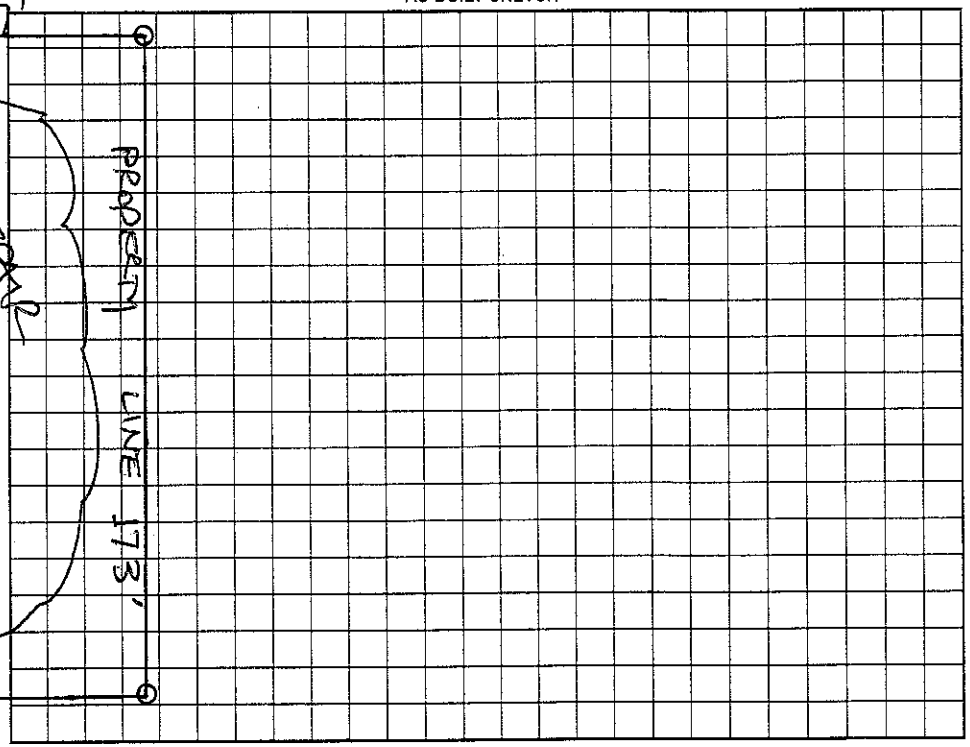

OLIN LOOP ROAD (SR 1681)

Permit can be suspended or revoked if any false information is supplied toward securing the permit/any unauthorized changes are made to the site/any unauthorized changes are made in the installation of the system. Improvement Permit with plat valid without expiration. Improvement Permit with site plan valid for sixty months. Authorization to Construct is valid for a period equal to that of Improvement Permit – not to exceed sixty months.

Signed: + Ken Speece date 10-22-02 Installed by: KENNY MADISON

Improvement Permit by: STEVE HEDRICK date 10-22-02 Operation Permit by: date 8-14-03

Authorization to Construct by: STEVE HEDRICK date 10-22-02 Existing System Inspection by: date

HEALTH DEPT. COPY: WHITE OWNER COPY (FINAL): YELLOW OWNER COPY (INITIAL): PINK