IREDELL COUNTY HEALTH DEPARTMENT

Statesville Office (704) 878-5305 Mooresville Office (704) 660-3625 PERMIT # 202757

BP

IMPROVEMENT PERMIT / AUTHORIZATION TO CONSTRUCT / OPERATION PERMIT / EXISTING SYSTEM

PIN # 4850660299

APPLICANT: Paul Bortree APPLICANT ADDRESS: 617 Tatum Rd Olin NC 28660

SITE ADDRESS: 617 Tatum Rd Olin NC 28660 PHONE: 704-221-5430 ALT. PHONE: N/A

SITE DIRECTIONS: I77 to Tomlin Mill Rd T/R then T/L Josey Rd T/L Olin LP T/R Tatum Rd

SUBDIVISION: BRAY ESTATES SECTION: N/A LOT # 34 LOT AREA: 4.549ac DESIGN FLOW: 360 L.T.A.R.: .3

Septic Tank: Existing (gal) STB: Date: 9-4

Pump Tank: 1000 (gal) PT: 363-1000 Date:

Pump Make: Model: Serial #:

Nitrification Fields: 1 # Lines: 3 Linear Ft: 300

Trench Width: 36" Max. Trench Bottom Depth: 36" Gravel Depth: N/A

☐ New System ☒ Repair ☐ Expansion System Type: I II (III) IV V VI

System Description: Pump - 25% Reduction

Repair System Description:

Maintenance Agreement Required: ☐ YES ☒ NO ☐ GRAVITY ☒ PRESSURE

☒ Residence ☐ Business ☐ Other ☐ Slab ☒ Basement w/plumbing


No. Bedrooms: 3 No. Persons: 6 No. Employees: Crawl Space

Water Supply: ☒ Private ☐ Public ☐ Community

☐ Basement w/o plumbing

Comments / Conditions: Install 25% reduction on Contour with pressure distribution. Check tank Check tee, replace if necessary.

INITIAL SITE SKETCH

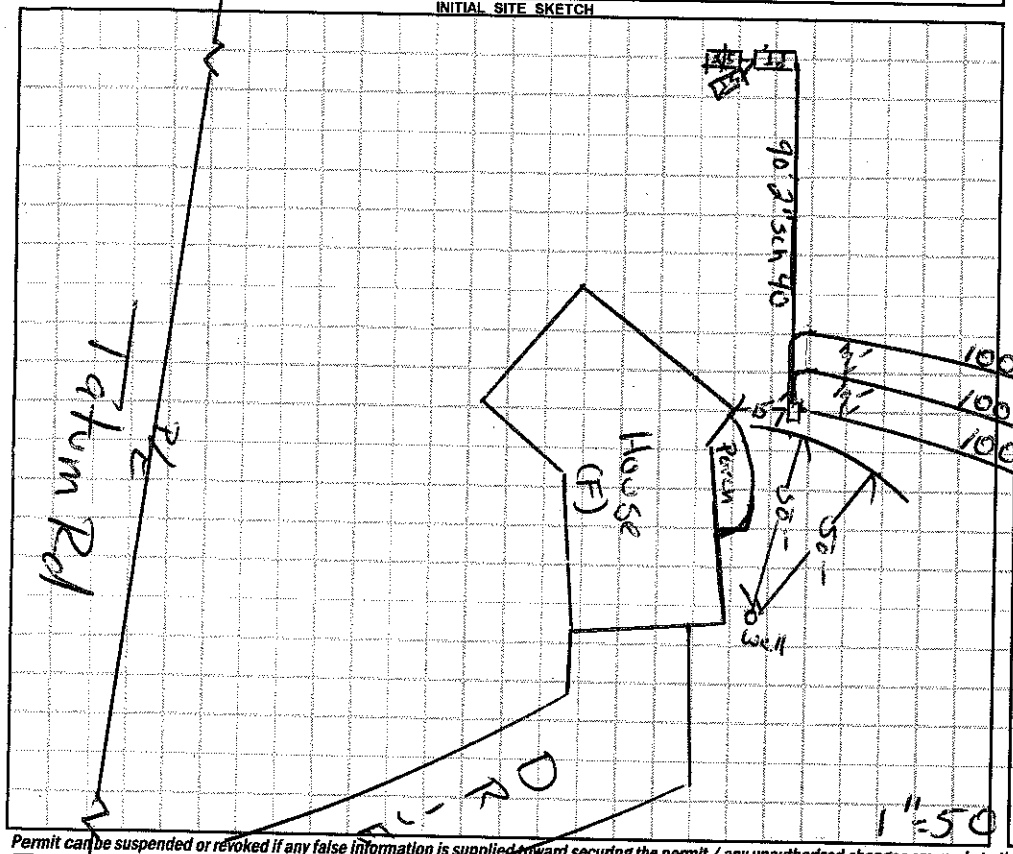

AS BUILT SKETCH

- Installed as drawn
- Quick 4 chambers installed

	Date	Initials
Drain Lines Checked	5-30-14	JH
Tanks Checked	5-30-14	JH
Pressure Manifold or Valve Box Checked	6-5-14	JH
Pressure Head Set	6-5-14	JH
Electrical Checked	6-5-14	JH
Floats Set	6-5-14	JH
Alarm Checked	6-5-14	JH
Maintenance Contract Y / N	N/A	

Permit can be suspended or revoked if any false information is supplied toward securing the permit / any unauthorized changes are made to the site / any unauthorized changes are made in the installation of the system. **CONTACT A LOCATOR SERVICE PRIOR TO ANY EXCAVATION**

☐ **IMPROVEMENT PERMIT** *with plat valid without expiration.* ☒ **IMPROVEMENT PERMIT** *with site plan valid for 60 mos.* ☒ **AUTHORIZATION TO CONSTRUCT** *valid for period equal to IMPROVEMENT PERMIT--not to exceed 60 mo.*

Owner / Applicant Signature: Paul Bortree Date: 5/14/14 Installed by: Gunter Grading

IMPROVEMENT PERMIT by: Debbie H. Brown Date: 05/12/14 OPERATION PERMIT by: Justin Anderson Date: 6-5-14

AUTHORIZATION TO CONSTRUCT by: Debbie H. Brown Date: 05/12/14 Existing System Inspected by: Date:

Health Dept. Copy - WHITE Applicant (Final Approval) - YELLOW Applicant (Conditional Approval) - PINK