HEATHER THOMAS

IREDELL COUNTY HEALTH DEPARTMENT

STATESVILLE 704-878-5305 MOORESVILLE 704-664-5281

4850-70-7589

IMPROVEMENT PERMIT / AUTHORIZATION TO CONSTRUCT / OPERATION PERMIT / EXISTING SYSTEM INSPECTION

PERMIT# 110480 PIN# ~~FLEETWOOD HOMES of NEWTON 4850-61-5178.10~~ DATE 1-8-03

OWNER OR CONTRACTOR FLEETWOOD HOMES OF NEWTON PHONE: Business 828-464-0767 Home HEATHER THOMAS 704-873-3403

ADDRESS 1155 US HWY 70 WEST, NEWTON, NC 28658

LOCATION I-77 NORTH TR TOMLIN MILL ROAD, TL RASH ROAD, TL ASHTON MANOR LANE, 2ND LOT ON LEFT

SUBDIVISION WARREN HICKORY SECTION / SECTION 2 LOT 10 LOT AREA 1.5 ACRES SITE CLASS. PS DESIGN FLOW 360 L.T.A.R. 0.25 GPD/FT²

Septic Tank: 1000 Gallons; STB 1007 Date 12-10-02

Pump Tank: _____ Gallons; PT _____ Date _____

Pump Make: _____ Model _____ Serial No. _____

Nitrification Field: No Fields 1 Square Feet 1440 Linear Feet 480

No Lines SIX Trench Width 36" Max Trench Bottom Depth 36" Gravel Depth 12" GRAVEL

☑ New System ☐ Repair System Type: I, II, III, IV, V, VI

System Description: CONVENTIONAL, GRAVITY

Repair System Description: CONVENTIONAL, PUMP

Maintenance Agreement Required: ☐ Yes ☑ No

☑ House/Mod. Home No. Bedrooms 3

☐ Mobile Home No. Bathrooms 2

☐ Business No. Employees ____

☐ Other _____


☐ Slab ☑ Crawl Space ☐ Basement w/plumbing ☐ Basement wo/plumbing

Water Supply: ☐ Individual ☑ Public ☐ Community


Comments:/Conditions: INSTALL SUBSURFACE INTERCEPT DRAINAGE DITCH AT LOCATION SHOWN BEGINNING 48" DEEP, AROUND SYSTEM THEN OUT TO DAYLIGHT.

Comments:/Conditions: SEPTIC TANK WITH MARKER INSTALLED USING "POLYLOK" FILTER STEVE HEDRICK W/D SYSTEM & TURNED DOWN FRENCH DRAIN, LOOKS LOOK W/D F.D. ON 4-11-03 & WAS OK.

INITIAL SITE SKETCH

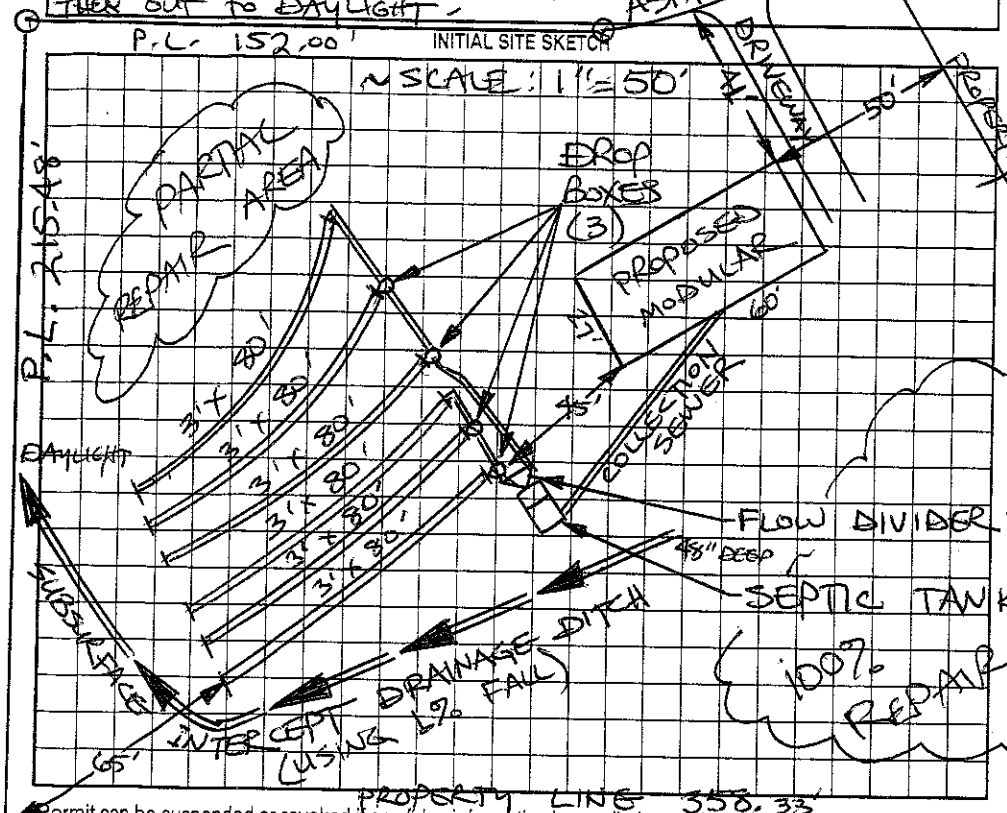

AS BUILT SKETCH

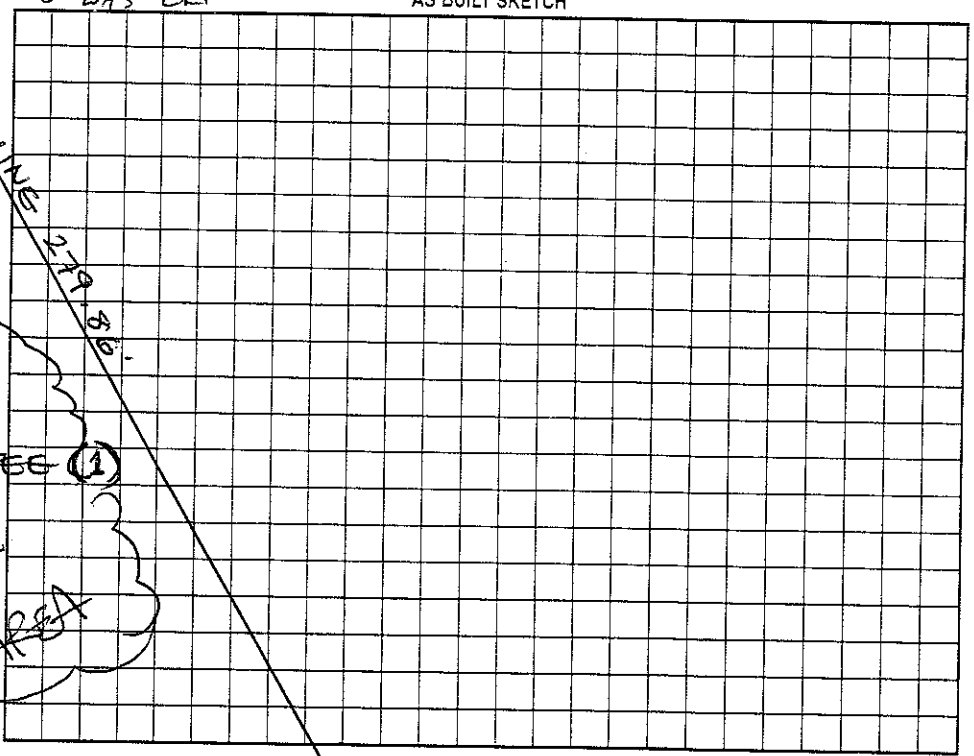

Permit can be suspended or revoked if any false information is supplied toward securing the permit/any unauthorized changes are made to the site/any unauthorized changes are made in the installation of the system. Improvement Permit with plat valid without expiration. Improvement Permit with site plan valid for sixty months. Authorization to Construct is valid for a period equal to that of Improvement Permit – not to exceed sixty months.

Signed: Heather Thomas date 1-9-03

Improvement Permit by: STEVE HEDRICK date 1-8-03

Authorization to Construct by: STEVE HEDRICK date 1-8-03

Installed by: K & M GRADING

Operation Permit by: _____ date 4-11-03

Existing System Inspection by: _____ date _____

HEALTH DEPT. COPY: WHITE OWNER COPY (FINAL): YELLOW OWNER COPY (INITIAL): PINK