IREDELL COUNTY HEALTH DEPARTMENT

STATESVILLE 704-878-5305 MOORESVILLE 704-664-5281

IMPROVEMENT PERMIT / AUTHORIZATION TO CONSTRUCT / OPERATION PERMIT / EXISTING SYSTEM INSPECTION

PERMIT# 126081 PIN# 4850-70-8083 58 DATE 3-2-05

OWNER OR CONTRACTOR JENNIFER & BRADLEY SUMMERS PHONE: Business (704) 791-3451 / 791-5427 Home

ADDRESS 1555 LENTZ HARNESS SHOP RD S MT PLEASANT NC 28124

LOCATION I-77 N TR TOMLIN MILL RD TL RASH RD 8/10 MI ON LT

SUBDIVISION HILKERT PROPERTY BLOCK / SECTION LOT 2 LOT AREA 4.0 SITE CLASS. PS DESIGN FLOW 360 L.T.A.R. 0.30 gpd/ft²

Septic Tank: 1000 Gallons; STB 1012 Date 8-27-04

Pump Tank: Gallons; PT Date

Pump Make: Model Serial No.

Nitrification Field: No Fields 1 Square Feet 1200 Linear Feet 400

No Lines 4 Trench Width 36" Max Trench Bottom Depth 24" Gravel Depth 12"

☒ New System ☐ Repair System Type: I, II, III, IV, V, VI

System Description: CONVENTIONAL GRAVITY

Repair System Description: SAME

Maintenance Agreement Required: ☐ Yes ☒ No

☒ House/Mod. Home No. Bedrooms 3

☐ Mobile Home No. Bathrooms

☐ Business No. Employees

☐ Other


☐ Slab ☒ Crawl Space ☐ Basement w/plumbing ☐ Basement wo/plumbing

Water Supply: ☒ Individual ☐ Public ☐ Community


Comments/Conditions: ① INSTALL LINES 24" ON CONTOUR ② INSTALL FRENCH DRAIN 36" TO DAYLIGHT ③ MAINTAIN SETBACKS FROM WELL & EASEMENT

Comments/Conditions: ① 'TUFF-TITE' FILTER ② RISER ON TANK ③ #57 STONE ④ FRENCH W/ FALL TO DAYLIGHT DRAIN 5½"

INITIAL SITE SKETCH

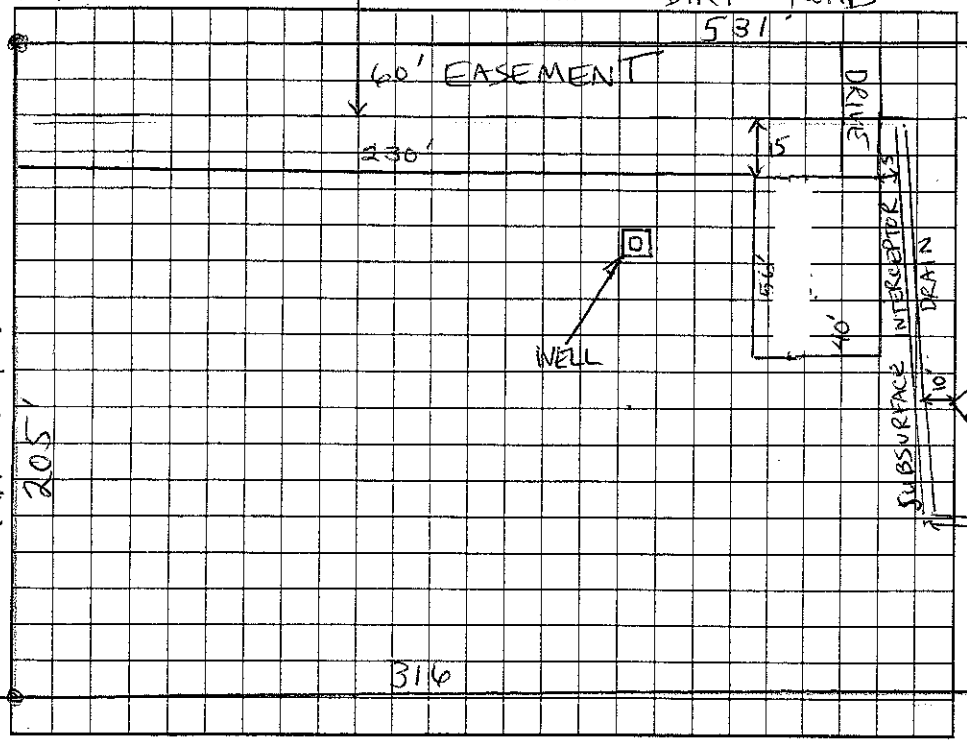

AS BUILT SKETCH

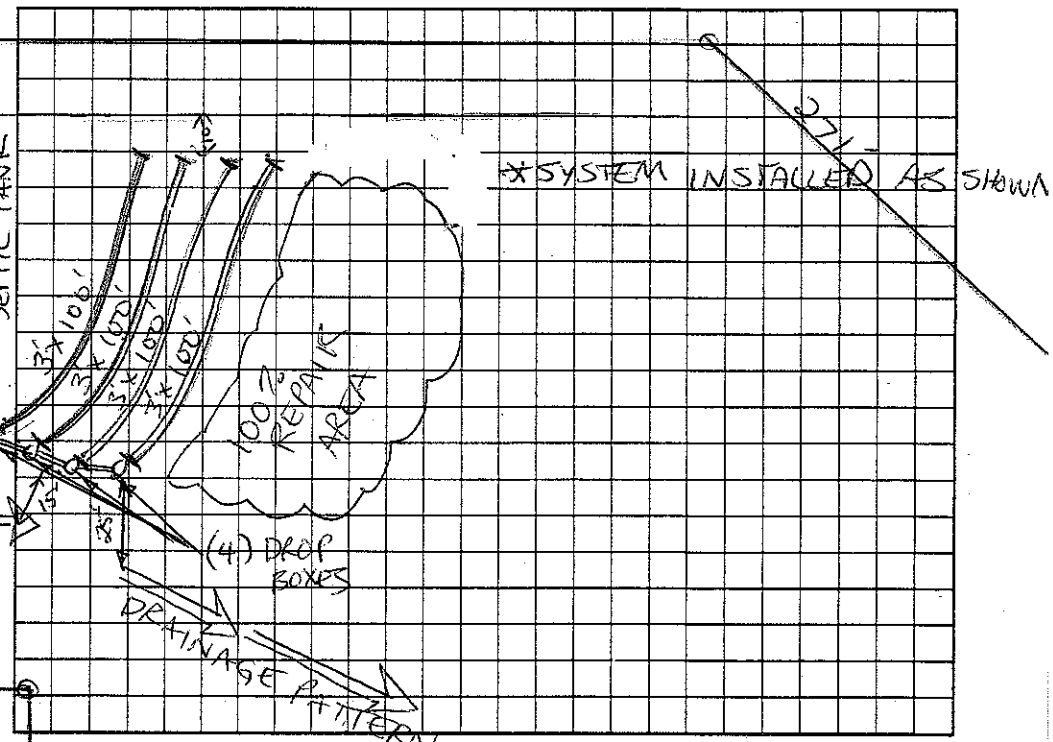

Permit can be suspended or revoked if any false information is supplied toward securing the permit/any unauthorized changes are made to the site/any unauthorized changes are made in the installation of the system. Improvement Permit with plat valid without expiration. Improvement Permit with site plan valid for sixty months. Authorization to Construct is valid for a period equal to that of Improvement Permit – not to exceed sixty months.

Signed: [signature] date 3-4-05 Installed by: A-1 BACKHOE

Improvement Permit by: [signature] REHS 645 date 3-2-05 Operation Permit by: [signature] REHS 645 date 4-20-05

Authorization to Construct by: [signature] REHS 645 date 3-2-05 Existing System Inspection by: date

HEALTH DEPT. COPY: WHITE OWNER COPY (FINAL): YELLOW OWNER COPY (INITIAL): PINK