IREDELL COUNTY HEALTH DEPARTMENT

STATESVILLE 704-878-5305 MOORESVILLE 704-664-5281

IMPROVEMENT PERMIT / AUTHORIZATION TO CONSTRUCT / OPERATION PERMIT / EXISTING SYSTEM INSPECTION

PERMIT# 152870 PIN# 4850720025 DATE 10/9/08

OWNER OR APPLICANT Kevin Tennant PHONE: Business 704 876 4057 Home 704 902 4688

ADDRESS 415 Rash Rd Ola NC 28660

LOCATION From Statesville, NC Hwy 77 N to exit 59; Right on Tomlin Mill Rd, left on Rash Rd - Property 1.1 miles on left

SUBDIVISION n/a BLOCK / SECTION n/a LOT n/a LOT AREA 20.37 SITE CLASS. PS DESIGN FLOW @480 L.T.A.R. EX.

Septic Tank: 1000 Gallons: STB ____ Date ____

Pump Tank: ____ Gallons: PT ____ Date ____

Pump Make: ____ Model ____ Serial No. ____

Nitrification Field: No Fields 1 Square Feet 1600 Linear Feet 533

No Lines 4 Trench Width 36" Max Trench Bottom Depth 36" Gravel Depth 12" ☒ Gravity ☐ Pressure

☐ New System ☐ Repair ☐ Expansion System Type: I (II) III IV V VI

System Description: Ex.

Repair System Description: Ex

Maintenance Agreement Required: ☐ Yes ☒ No

☑ House/Mod. Home No. Bedrooms 4

☐ Mobile Home No. Persons ____

☐ Business No. Employees ____

☐ Other ____

Water Supply: ☐ Individual ☑ Public ☐ Community


☑ Slab ☑ Crawl Space ☐ Basement w/plumbing ☐ Basement wo/plumbing

Comments:/Conditions:

Comments:/Conditions:

INITIAL SITE SKETCH

AS BUILT SKETCH

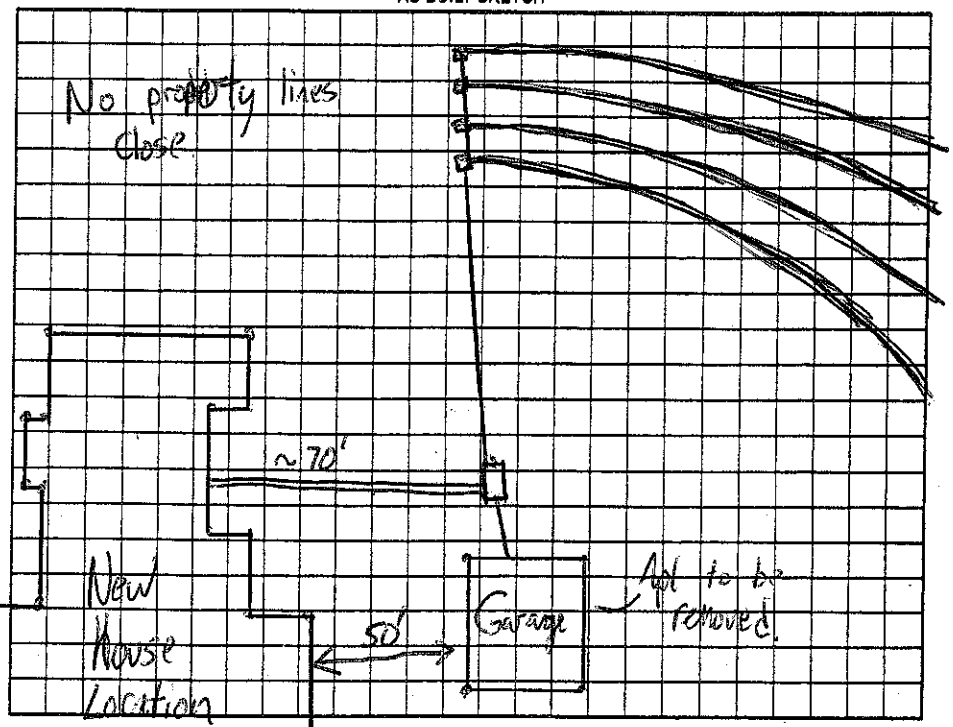

Permit can be suspended or revoked if any false information is supplied toward securing the permit/any unauthorized changes are made to the site/any unauthorized changes are made in the installation of the system. Improvement Permit with plat valid without expiration ☐ Improvement Permit with site plan valid for sixty months ☒ Authorization to Construct is valid for a period equal to that of Improvement Permit – not to exceed sixty months.

Signed ____ date 10-10-08 Installed by: ____

Improvement Permit by: ____ date ____ Operation Permit by: ____ date ____

Authorization to Construct by: ____ date ____ Existing System Inspection by: ____ date 10/9/8

HEALTH DEPT. COPY: WHITE OWNER COPY (FINAL): YELLOW OWNER COPY (INITIAL): PINK