IREDELL COUNTY HEALTH DEPARTMENT

STATESVILLE 704-878-5305 MOORESVILLE 704-664-5281

IMPROVEMENT PERMIT / AUTHORIZATION TO CONSTRUCT / OPERATION PERMIT / EXISTING SYSTEM INSPECTION

PERMIT# 071269 PIN# 4850 72 9653 DATE 1-20-98

OWNER OR CONTRACTOR BRENDA J. DALTON PHONE: Business Home 873-2582

ADDRESS 103 HAMBY LANE, STATESVILLE NC 28625

LOCATION I-77 N, TR TOMLIN MILL RD, TR RASH ROAD, 1.4 MILE ON RIGHT

SUBDIVISION BLOCK / SECTION LOT LOT AREA 1.0 ACRE SITE CLASS. PS DESIGN FLOW 240 L.T.A.R. 0.30 GPD/FT²

Septic Tank: 1000 Gallons; STB 786 Date ~~7-86~~ 8-21-98

Pump Tank: Gallons; PT Date

Pump Make: Model Serial No.

Nitrification Field: No Fields 1 Square Feet 810 Linear Feet 270

No Lines FOUR Trench Width 36" Max Trench Bottom Depth 30" Gravel Depth 12"

☑ New System ☐ Repair System Type: I, II, III, IV, V, VI

System Description: CONVENTIONAL GRAVITY

Repair System Description: CONV. GRAVITY

Maintenance Agreement Required: ☐ Yes ☑ No

☐ House/Mod. Home ☑ Mobile Home ☐ Business ☐ Other

No. Bedrooms 2 No. Bathrooms 2 No. Employees

Water Supply: ☐ Individual ☐ Public ☐ Community


☐ Slab ☑ Crawl Space ☐ Basement w/plumbing ☐ Basement wo/plumbing

Comments:/Conditions: (1) INSTALL SUBSURFACE INTERCEPT DRAINAGE DITCH AS SHOWN BEGINNING 4'2" DEEP & OUT TO DAYLIGHT (2) KEEP SYSTEM MINIMUM 100' FROM NEIGHBORING WELL

Comments:/Conditions: Mobile Home not on site time of inspection

SCALE: 1"=50'

INITIAL SITE SKETCH

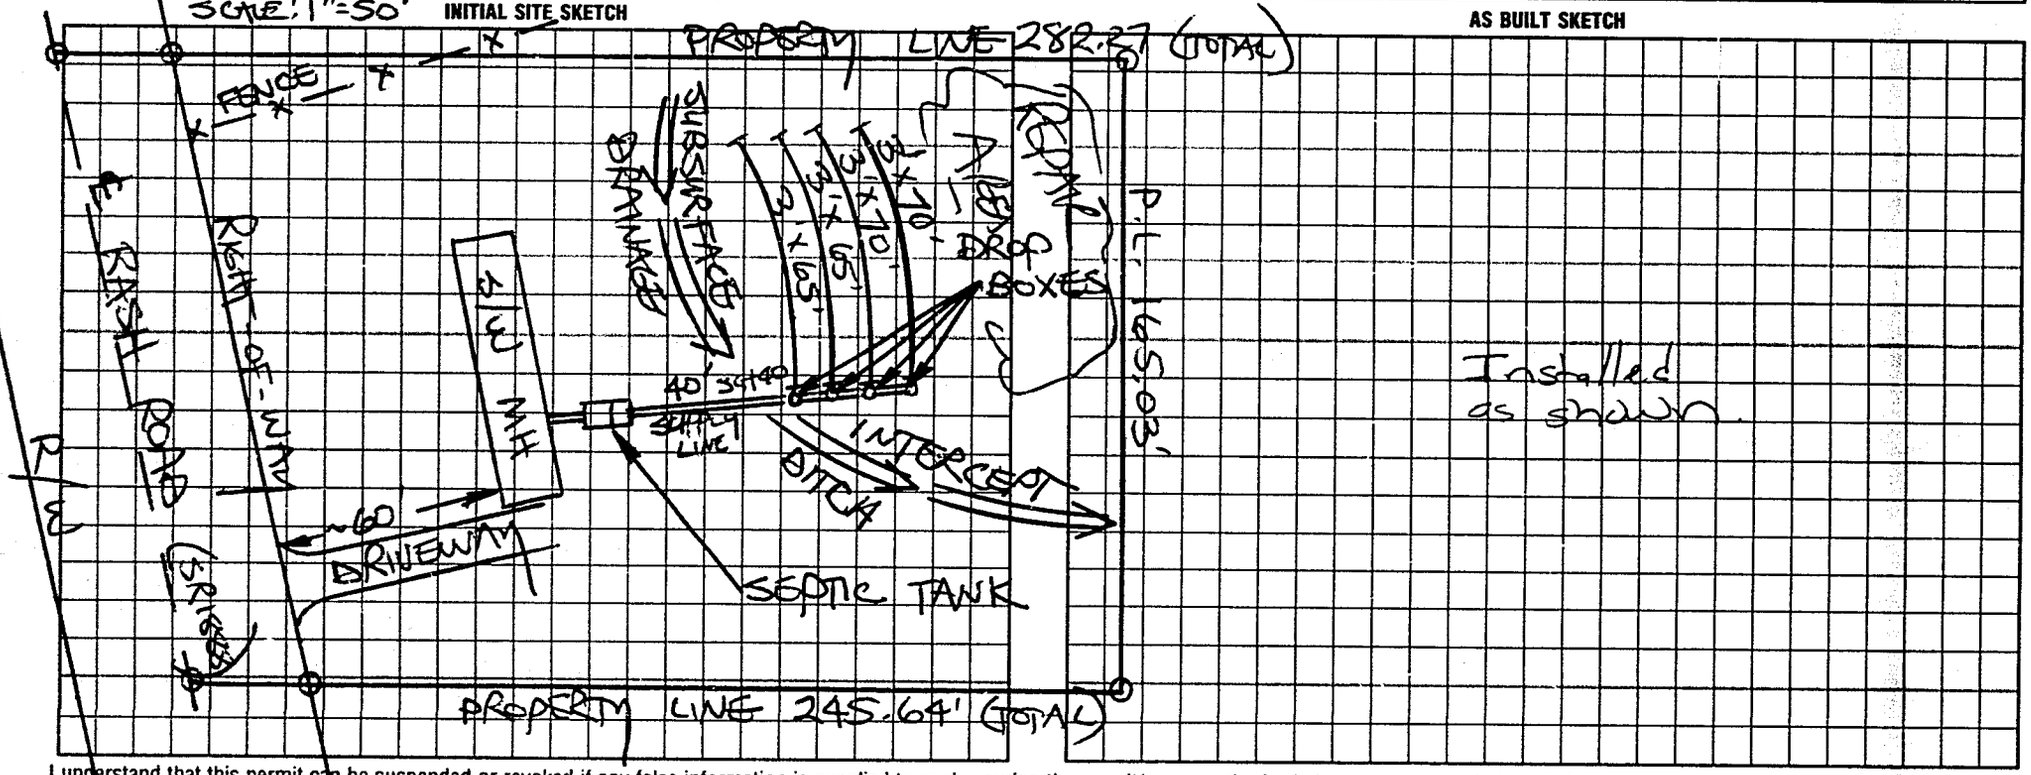

AS BUILT SKETCH

Installed as shown.

I understand that this permit can be suspended or revoked if any false information is supplied toward securing the permit/any unauthorized changes are made to the site/any unauthorized changes are made in the installation of the system. Improvement Permit with plat valid without expiration. Improvement Permit with site plan valid for sixty months. Authorization to Construct is valid for a period equal to that of Improvement Permit – not to exceed sixty months.

Signed: Brenda J. Dalton date 1-20-98

Improvement Permit by: STEVE HEDRICK date 1-20-98

Authorization to Construct by: STEVE HEDRICK date 1-20-98

Installed by: Leatherman Septic

Operation Permit by: [illegible] date 9-17-98

Existing System Inspection by: date

HEALTH DEPT. COPY: WHITE INSPECTION COPY (FINAL): GREEN OWNER COPY (FINAL): YELLOW INSPECTION COPY (INITIAL): PINK OWNER COPY (INITIAL): GOLD