IREDELL COUNTY HEALTH DEPARTMENT

STATESVILLE 704-878-5305 MOORESVILLE 704-664-5281

IMPROVEMENT PERMIT / AUTHORIZATION TO CONSTRUCT / OPERATION PERMIT / EXISTING SYSTEM INSPECTION

PERMIT# 081511 PIN# 4850 82 2588 DATE 6-2-99

OWNER OR CONTRACTOR TORYA STEVENSON PHONE: Business Home 546-2949

ADDRESS 352 TOMLIN ROAD, HARMONY, NC 28634

LOCATION I-77 N, TR TOMLIN MILL RD, TL RASH ROAD, 1.3 MILES ON RIGHT

SUBDIVISION BLOCK / SECTION LOT LOT AREA 10.00 ACRES SITE CLASS PS DESIGN FLOW 360 L.T.A.R. 0.30 GPD/FT²

Septic Tank: 1000 Gallons; STB 825 Date 8-10-01

Pump Tank: Gallons; PT Date

Pump Make: Model Serial No.

Nitrification Field: No Fields 1 Square Feet 1200 Linear Feet 400

No Lines FIVE Trench Width 36" Max Trench Bottom Depth 36" Gravel Depth 12"

☑ New System ☐ Repair System Type: I. II. III. IV. V. VI

System Description: CONVENTIONAL GRAVITY

Repair System Description: CONV. GRAVITY

Maintenance Agreement Required: ☐ Yes ☑ No

☐ House/Mod. Home ☐ Mobile Home ☐ Business ☐ Other

No. Bedrooms 3 No. Bathrooms 2 No. Employees


☐ Slab ☑ Crawl Space ☐ Basement w/plumbing ☐ Basement wo/plumbing

Water Supply: ☐ Individual ☑ Public ☐ Community


Comments:/Conditions:

Comments:/Conditions: Poly Lok Filter Installed
DW on lot, 20' from PL on 10-16-01.

INITIAL SITE SKETCH

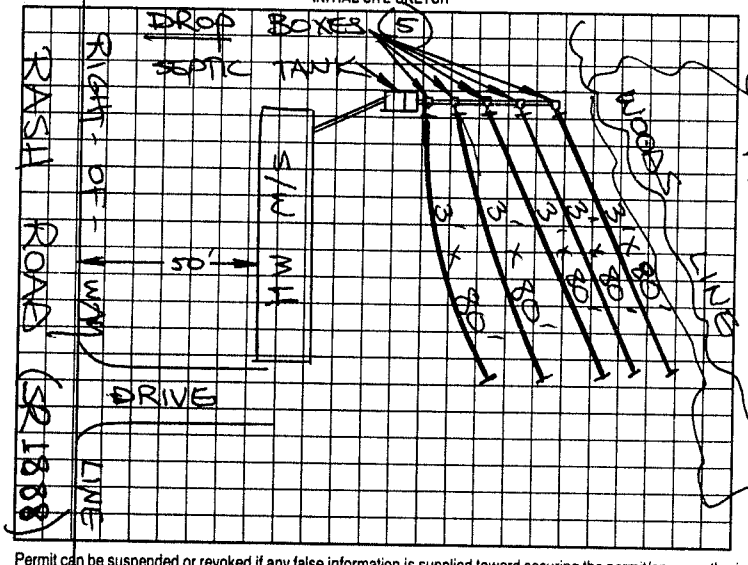

AS BUILT SKETCH

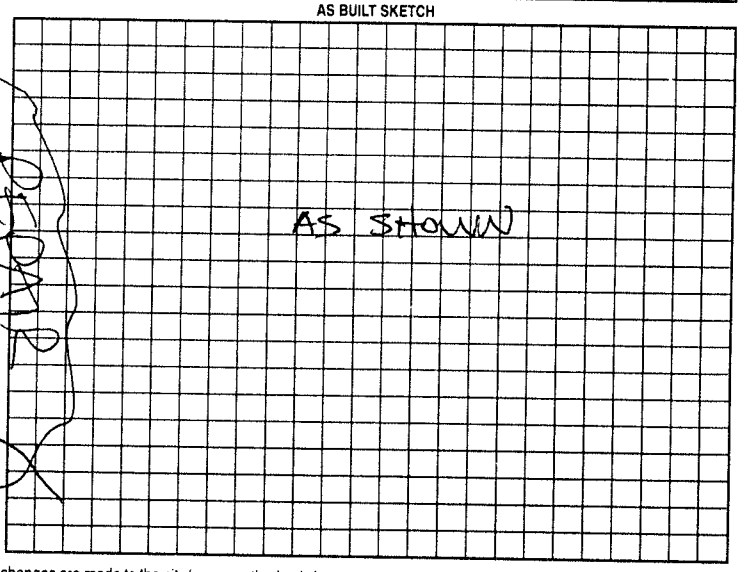

Permit can be suspended or revoked if any false information is supplied toward securing the permit/any unauthorized changes are made to the site/any unauthorized changes are made in the installation of the system. Improvement Permit with plat valid without expiration. Improvement Permit with site plan valid for sixty months. Authorization to Construct is valid for a period equal to that of Improvement Permit – not to exceed sixty months.

Signed: Tonya Stevenson date 6-2-99

Improvement Permit by: STEVE HEDRICK date 6-2-99

Authorization to Construct by: STEVE HEDRICK date 6-2-99

Installed by: Barger

Operation Permit by: STEVE HEDRICK date 11-2-01

Existing System Inspection by: date

HEALTH DEPT. COPY WHITE OWNER COPY (FINAL) YELLOW OWNER COPY (INITIAL) PINK