IREDELL COUNTY HEALTH DEPARTMENT

Statesville Office (704) 878-5305 Mooresville Office (704) 660-3625 PERMIT # 213941

IMPROVEMENT PERMIT / AUTHORIZATION TO CONSTRUCT / OPERATION PERMIT / EXISTING SYSTEM

PIN # 4850863686

APPLICANT: Abee's Cleasing + Grading APPLICANT ADDRESS: 2381 US Hwy 64 West

SITE ADDRESS: 496 Tatum Rd. PHONE: 704-239-3693 ALT. PHONE: N/A


SITE DIRECTIONS: Denning Rd to Olin LP to Tatum Rd. Property on Left.

SUBDIVISION: Robert Tatum SECTION: N/A LOT # 1 LOT AREA: 1.65 acres DESIGN FLOW: 360gpd L.T.A.R.: 0.0225


Septic Tank	1000 (gal)	STB	760-1000	Date	12-22	☐ New System ☐ Repair ☐ Expansion	System Type: I II (III) IV V VI	☑ Residence	No. Bedrooms	3	Water Supply ☑ Private
Pump Tank	(gal)	PT		Date		System Description:	25% Reduction	☐ Business	No. Persons	6	☐ Public
Pump Make		Model		Serial #		Repair System Description:	Shallow 25% Red w/ CAT	☐ Other	No. Employees		☐ Community
# Nitrification Fields	1	# Lines	3	Linear Ft:	334'	Maintenance Agreement Required:	☐ YES ☑ NO	☐ Slab	☑ Crawl Space		
Trench Width	36"	Max. Trench Bottom Depth	30"	Gravel Depth	N/A		☑ GRAVITY ☐ PRESSURE	☐ Basement w/plumbing		☐ Basement w/o plumbing	

Comments / Conditions: IMPROVEMENTS ONLY! Submit Letter of permission to install collection sewer through utility easement prior to issuance of CA's. Install a 25% Reduction system on Contour with serial distribution. DRIVEWAY cut shall be a minimum of 15' below system Area. * Collection sewer must be a minimum of 36" deep through power line easement per Duke Energy *

INITIAL SITE SKETCH

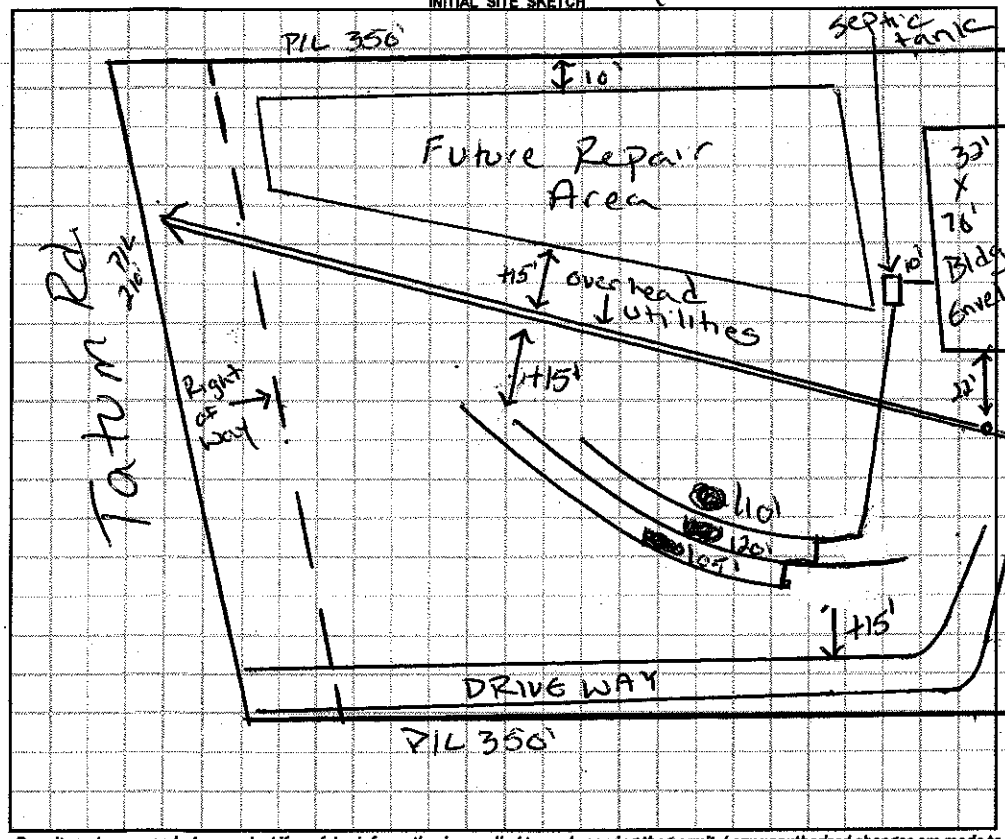

AS BUILT SKETCH

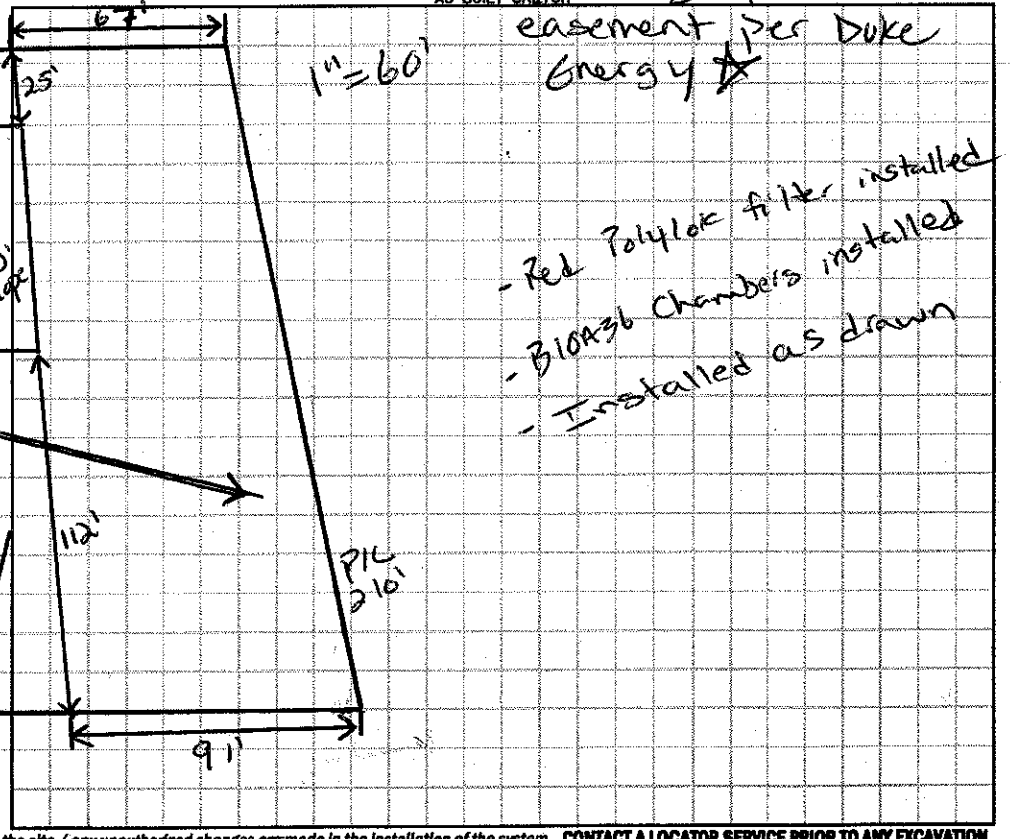

Permit can be suspended or revoked if any false information is supplied toward securing the permit / any unauthorized changes are made to the site / any unauthorized changes are made in the installation of the system. **CONTACT A LOCATOR SERVICE PRIOR TO ANY EXCAVATION**

☐ **IMPROVEMENT PERMIT** *with plat valid without expiration.* ☑ **IMPROVEMENT PERMIT** *with site plan valid for 60 mos.* ☑ **AUTHORIZATION TO CONSTRUCT** *valid for period equal to IMPROVEMENT PERMIT--not to exceed 60 mo.*

Owner / Applicant Signature: Deena Abee / Deena Abee Date: 9/16/15 Installed by: Tim Abee

IMPROVEMENT PERMIT by: Justin Henderson Date: 12-10-15 OPERATION PERMIT by: Justin Henderson Date: 3-17-16

AUTHORIZATION TO CONSTRUCT by: Justin Henderson Date: 1-19-16 Existing System Inspected by: Date:

Health Dept. Copy - WHITE Applicant (Final Approval) - YELLOW Applicant (Conditional Approval) - PINK