IREDELL COUNTY HEALTH DEPARTMENT

STATESVILLE 704-878-5305 MOORESVILLE 704-664-5281

IMPROVEMENT PERMIT / AUTHORIZATION TO CONSTRUCT / OPERATION PERMIT / EXISTING SYSTEM INSPECTION

PERMIT# 125273 PIN# 4851-13-8837 780 DATE 12/20/04

OWNER OR CONTRACTOR TONY PRICE PHONE: Business (704) 902-1839 Home

ADDRESS 343 SLOANS MILL RD OLIN NC 28660

LOCATION I-77N EXIT 59 TL TOMLIN MILL TR JENNINGS TR 2ND OLIN RD. TL SLOANS MILL 1 MILE ON LEFT

SUBDIVISION BLOCK / SECTION LOT LOT AREA 5.0 SITE CLASS. PS DESIGN FLOW 240 L.T.A.R. 0.30 gpd/ft²

Septic Tank: 1000 Gallons; STB 1007 Date 4-12-05
Pump Tank: Gallons; PT Date
Pump Make: Model Serial No.
Nitrification Field: No Fields 1 Square Feet 800 Linear Feet 270
No Lines 3 Trench Width 36" Max Trench Bottom Depth 24" Gravel Depth 12"

☑ New System ☐ Repair System Type: I (II) III, IV, V, VI
System Description: CONVENTIONAL GRAVITY
Repair System Description: GRAVITY 25% RED
Maintenance Agreement Required: ☐ Yes ☑ No


☐ House/Mod. Home No. Bedrooms 2
☑ Mobile Home No. Bathrooms
☐ Business No. Employees
☐ Other
☐ Slab ☑ Crawl Space ☐ Basement w/plumbing ☐ Basement wo/plumbing

Water Supply: ☐ Individual ☑ Public ☐ Community


Comments/Conditions: ① INSTALL LINES 24" ON CONTOUR
② MAINTAIN ALL SETBACKS.

Comments/Conditions: SYSTEM INSTALLED AS SHOWN
TANK HAS 'ZABEL' FILTER & MARKER ON TANK

INITIAL SITE SKETCH * 1" = 50'

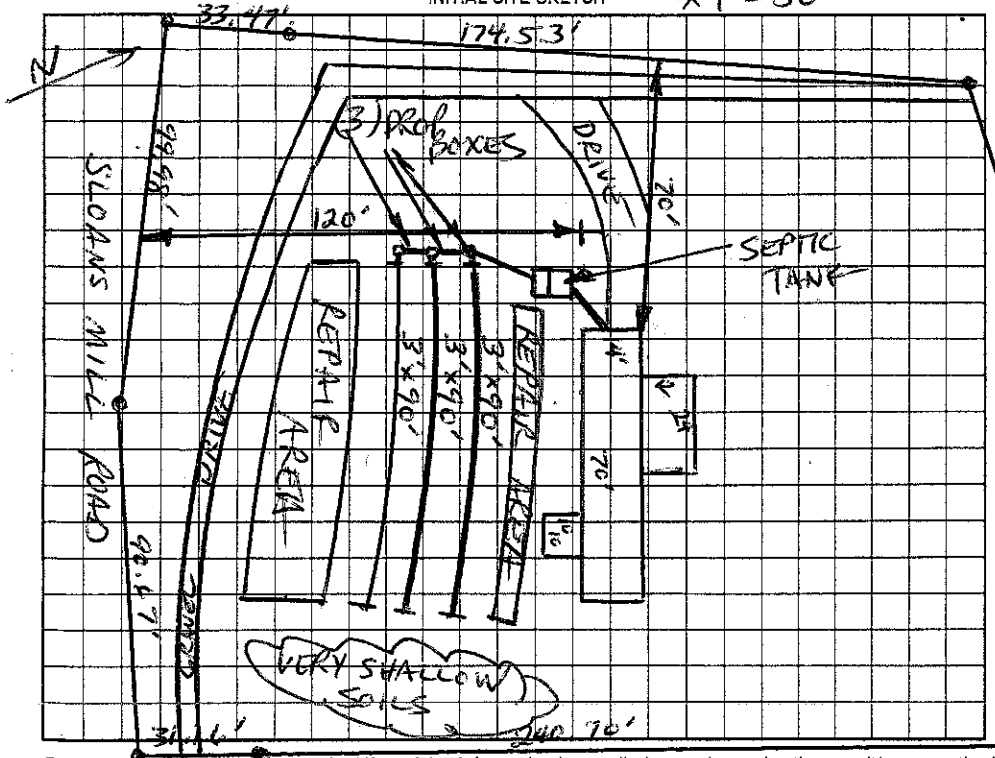

AS BUILT SKETCH

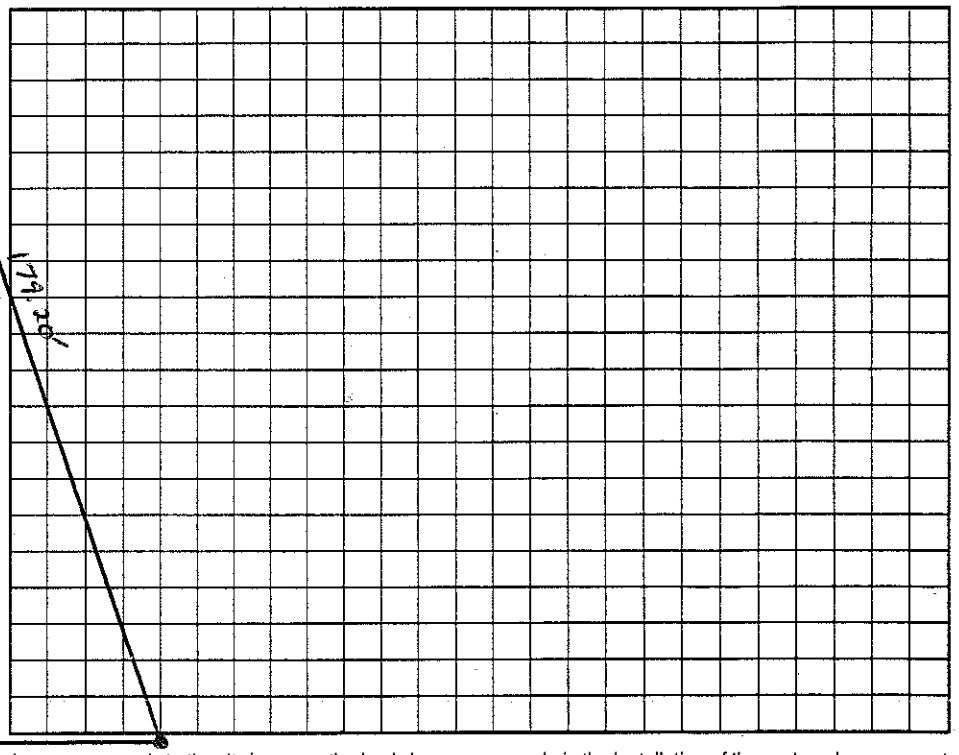

Permit can be suspended or revoked if any false information is supplied toward securing the permit/any unauthorized changes are made to the site/any unauthorized changes are made in the installation of the system. Improvement Permit with plat valid without expiration. Improvement Permit with site plan valid for sixty months. Authorization to Construct is valid for a period equal to that of Improvement Permit – not to exceed sixty months.

Signed: date 05-12-2 Installed by: KENNY MADISON

Improvement Permit by: Christopher M. Shemwell, PS date 12-20-04 Operation Permit by: Christopher M. Shemwell, PS 555 date 5-23-05

Authorization to Construct by: Christopher M. Shemwell, PS date 12-20-04 Existing System Inspection by: date

HEALTH DEPT. COPY: WHITE OWNER COPY (FINAL): YELLOW OWNER COPY (INITIAL): PINK