IREDELL COUNTY HEALTH DEPARTMENT

STATESVILLE 704-878-5305 MOORESVILLE 704-664-5281

IMPROVEMENT PERMIT / CERTIFICATE OF COMPLETION / OPERATION PERMIT / EXISTING SYSTEM INSPECTION

PROPERTY DESCRIPTION NO. 16753 DATE 8/4/93 TAX MAP NO. 13R-A-4

OWNER OR CONTRACTOR JOHNNIE E. MOORE PHONE: Business Home 876-1745

ADDRESS P.O. BOX 4 OLIN NC 28660

LOCATION US 21 N, TL JENNINGS RD, TR OLIN ROAD (NORTH), TL SLOANS MILL RD, ON (R) N 0.5 mi

SUBDIVISION BLOCK / SECTION LOT LOT AREA 7 ACRES SITE CLASS. PS L.T.A.R. 0.3 GPD/FT²

Water Supply: ☑ Individual ☐ Community ☐ Public WELL

Septic Tank: 1000 Gallons; STB 358 Date 6/29/93

Pump Tank: Gallons; PT Date

Nitrification Field: No Fields 1 Square Feet 780 Linear Feet 260

No Lines 3 Trench Width 36" Trench Depth ≤ 36" Gravel Depth 12"

☑ New System ☐ Repair System Type: I (II) III, IV, V, VI

System Description: CONV. GRAVITY

Repair System Description: CONV. GRAVITY

Maintenance Agreement Required: ☐ Yes ☑ No

☐ House/Mod. Home No. Bedrooms 2

☐ Mobile Home No. Bathrooms 1

☐ Business No. Employees

☐ Other

☐ Slab ☑ Crawl Space ☐ Basement w/plumbing ☐ Basement wo/plumbing

Garbage Disposal: ☐ Yes ☑ No


Auto. Dishwasher: ~~☑ Yes~~ ☐ No

Auto. Washing Machine: ~~☑ Yes~~ ☐ No


Other

Comments (1) KEEP SYSTEM MINIMUM 5' FROM MH, 10' FROM PROPERTY LINE, 100' FROM WELL (2) INSTALL LINES ON CONTOUR, NO DEEPER THAN 36", 9' ON CENTER

INITIAL SITE SKETCH

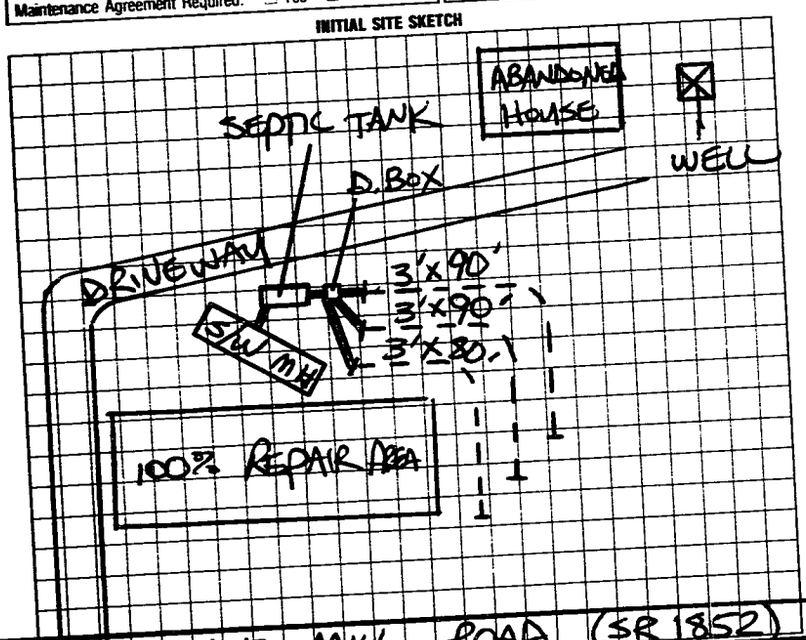

AS BUILT SKETCH

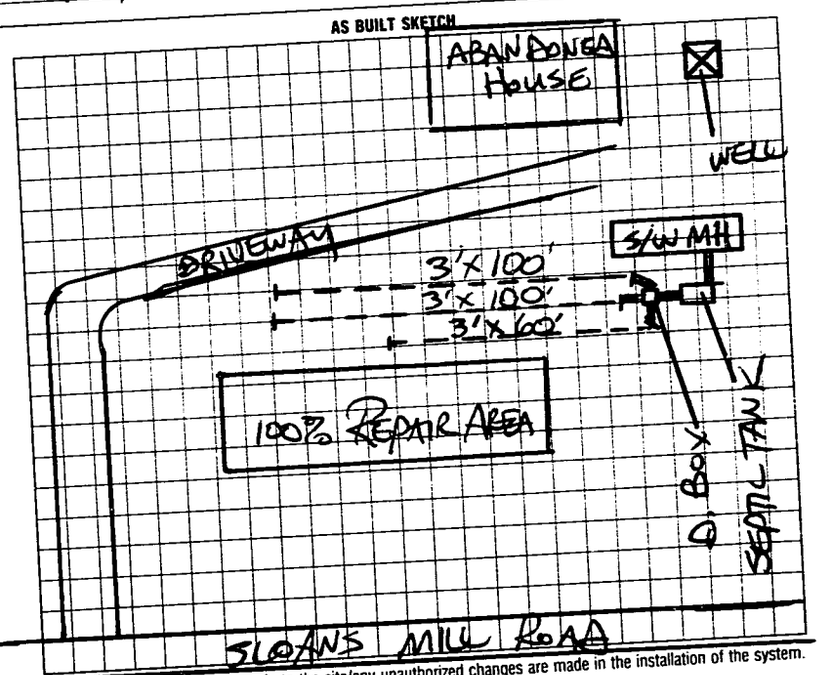

I understand that this permit can be suspended or revoked if any false information is supplied toward securing the permit/any unauthorized changes are made to the site/any unauthorized changes are made in the installation of the system. Improvement Permit is valid for 60 months from date of issuance.

Signed: X John K. Heather

Improvement Permit by: STEVE HEDRICK date 8/4/93

Existing System Inspection by: date

Installed by: A-1 BACKHOE

Certificate of Completion by: STEVE HEDRICK date 8/27/93

Operation Permit by: date

HEALTH DEPT. COPY: WHITE INSPECTION COPY (FINAL): GREEN OWNER COPY (FINAL): YELLOW INSPECTION COPY (INITIAL): PINK OWNER COPY (INITIAL): GOLD