IREDELL COUNTY HEALTH DEPARTMENT

STATESVILLE 704-878-5305 (C) MOORESVILLE 704-664-5281

IMPROVEMENT PERMIT / AUTHORIZATION TO CONSTRUCT / OPERATION PERMIT / EXISTING SYSTEM INSPECTION

PERMIT# 1060533 PIN# ~~4851-34-3449~~ 4851-34-2881 DATE 7-12-02

OWNER OR CONTRACTOR ~~CHRIS BALKCUM~~ ANNETTE MINNISH PHONE: Business Home 704-876-4553

ADDRESS 156 LEOTA LANE OLIN, NC 28660

LOCATION US 21 N, TL JENNINGS RD, TR OLIN LOOP ROAD (2ND), TL SLOANS MILL RD, TR LEOTA LANE, LOT ON RIGHT

SUBDIVISION BLOCK / SECTION LOT LOT AREA 1.0 ACRE SITE CLASS. PS DESIGN FLOW 360 L.T.A.R. 0.40 GPD/FT²

Septic Tank: 1000 Gallons; STB 794 Date 2-22-02
Pump Tank: Gallons; PT Date
Pump Make: Model Serial No.
Nitrification Field: No Fields 1 Square Feet 900 Linear Feet 300
No Lines FOUR Trench Width 36" Max Trench Bottom Depth 36" Gravel Depth 12"

☑ New System ☐ Repair System Type: I (II) III IV V VI
System Description: CONVENTIONAL, GRAVITY
Repair System Description: CONVENTIONAL, PUMP
Maintenance Agreement Required: ☐ Yes ☑ No


☐ House/Mod. Home No. Bedrooms 3
☑ Mobile Home No. Bathrooms 2
☐ Business No. Employees
☐ Other
☐ Slab ☑ Crawl Space ☐ Basement w/plumbing ☐ Basement wo/plumbing

Water Supply: ☑ Individual ☐ Public ☐ Community WELL

Comments/Conditions: KEEP SYSTEM MINIMUM 100 FEET FROM WELL


Comments/Conditions: SEPTIC TANK WITH MARKER & RISER INSTALLED USING "ZABEL" FILTER INSTALLED DURING PERIOD OF WET WEATHER

INITIAL SITE SKETCH

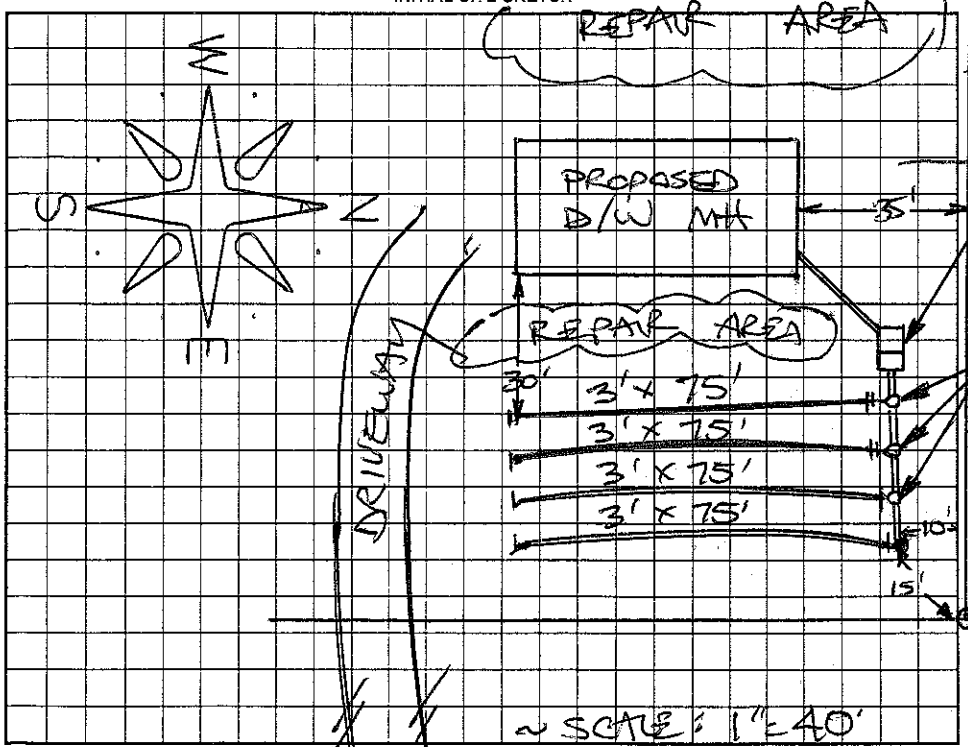

SCALE: 1" = 40'

AS BUILT SKETCH

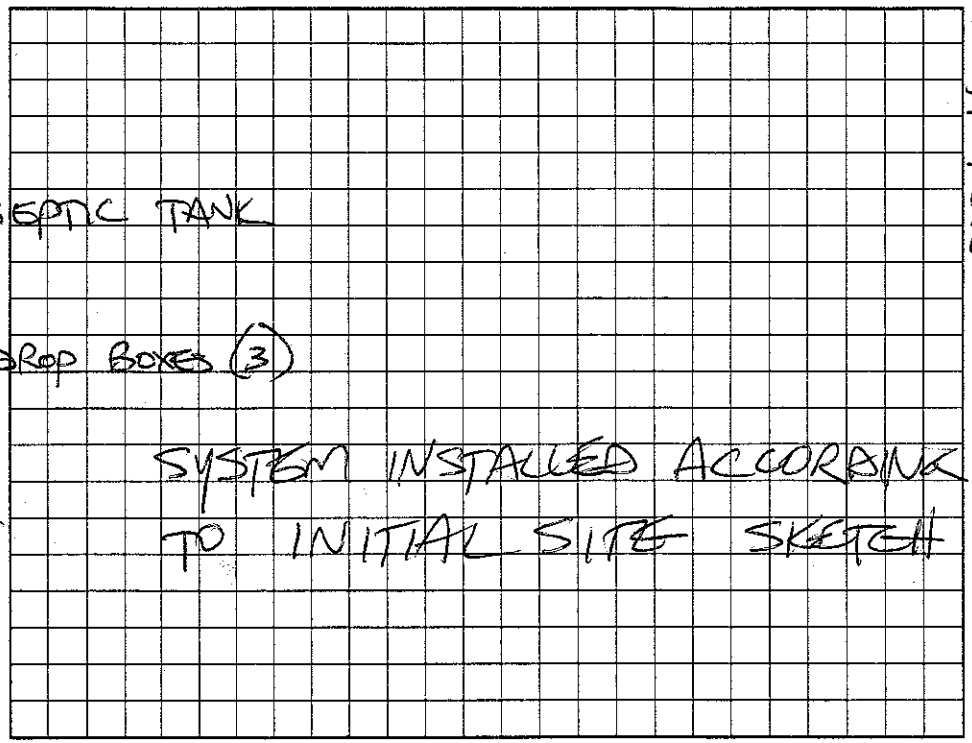


Permit can be suspended or revoked if any false information is supplied toward securing the permit/any unauthorized changes are made to the site/any unauthorized changes are made in the installation of the system. Improvement Permit with plat valid without expiration. Improvement Permit with site plan valid for sixty months. Authorization to Construct is valid for a period equal to that of Improvement Permit – not to exceed sixty months.

Signed: Annette Minnish date 7-12-02 Installed by: KENNY MADISON

Improvement Permit by: STEVE HEDRICK date 7-12-02 Operation Permit by: STEVE HEDRICK date 1-29-03

Authorization to Construct by: STEVE HEDRICK date 7-12-02 Existing System Inspection by: date

LEOTA LANE

HEALTH DEPT. COPY: WHITE OWNER COPY (FINAL): YELLOW OWNER COPY (INITIAL): PINK