IREDELL COUNTY HEALTH DEPARTMENT

STATESVILLE 704-878-5305 MOORESVILLE 704-664-5281

IMPROVEMENT PERMIT / AUTHORIZATION TO CONSTRUCT / OPERATION PERMIT / EXISTING SYSTEM INSPECTION

PERMIT# 075809 PIN# 4851 34 3553

OWNER OR CONTRACTOR NEWTON G. HOLLAND PHONE: Business Home 876-0273 DATE 8-14-98

ADDRESS 251 JOSEY ROAD STATESVILLE, NC 28625

LOCATION US 21 N, TL JENNINGS, TR OLD N ROAD (NORTH), TL SLOANS MILL, TR LEOTA LANE, ON RIGHT

SUBDIVISION BLOCK / SECTION LOT LOT AREA 11.84 ACRES SITE CLASS. PS DESIGN FLOW 240 L.T.A.R. 0.33 GPD/FT²

Septic Tank: 1000 Gallons; STB 10/12 Date 6-1-98

Pump Tank: Gallons; PT Date

Pump Make: Model Serial No.

Nitrification Field: No Fields 1 Square Feet 720 Linear Feet 240

No Lines THREE Trench Width 36" Max Trench Bottom Depth 36" Gravel Depth 12"

☑ New System ☐ Repair System Type: I, II, III, IV, V, VI

System Description: CONVENTIONAL, GRAVITY

Repair System Description: CONV. PUMP

Maintenance Agreement Required: ☐ Yes ☑ No

☐ House/Mod. Home ☑ Mobile Home ☐ Business ☐ Other

No. Bedrooms 3 No. Bathrooms 2 No. Employees

☐ Slab ☑ Crawl Space ☐ Basement w/plumbing ☐ Basement wo/plumbing


Water Supply: ☑ Individual ☐ Public ☐ Community WELL

BEFORE EXISTING HOUSE AT END

Comments:/Conditions:

Comments:/Conditions:

INITIAL SITE SKETCH SCALE: 1"=40'

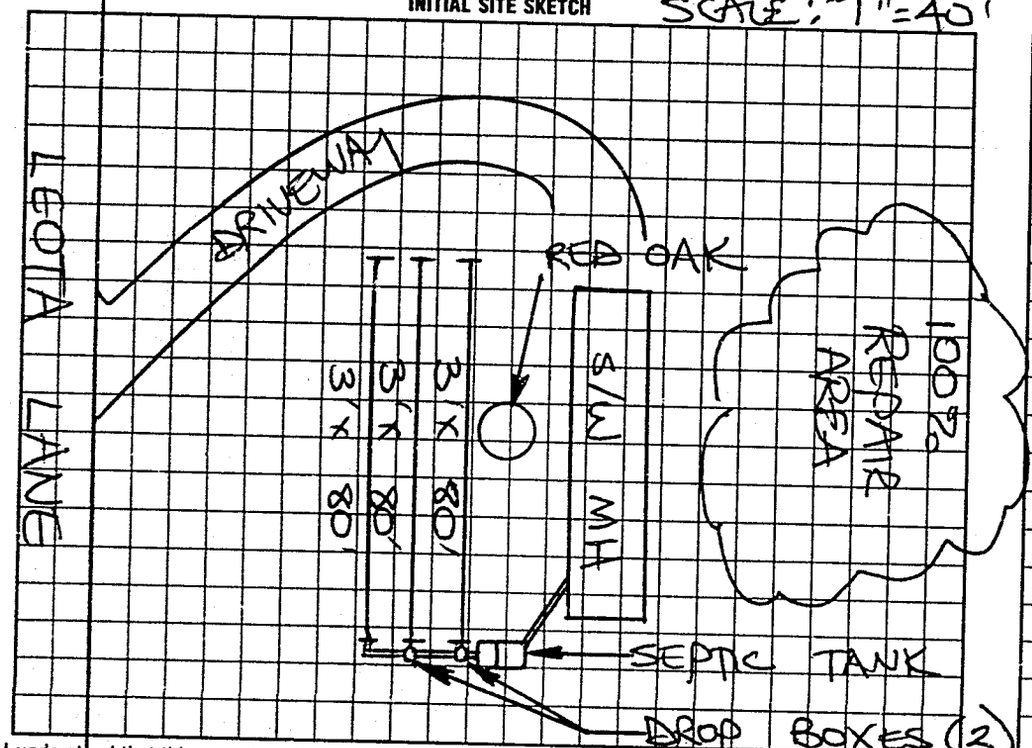

AS BUILT SKETCH

Installed as shown

I understand that this permit can be suspended or revoked if any false information is supplied toward securing the permit/any unauthorized changes are made to the site/any unauthorized changes are made in the installation of the system. Improvement Permit with plat valid without expiration. Improvement Permit with site plan valid for sixty months. Authorization to Construct is valid for a period equal to that of Improvement Permit – not to exceed sixty months.

Signed: T Newton G Holland C date 8-14-98

Improvement Permit by: STEVE HEDRICK date 8-14-98

Authorization to Construct by: STEVE HEDRICK date 8-14-98

Installed by: kenny Madison

Operation Permit by: [illegible] date 8-20-98

Existing System Inspection by: date

HEALTH DEPT. COPY: WHITE INSPECTION COPY (FINAL): GREEN OWNER COPY (FINAL): YELLOW INSPECTION COPY (INITIAL): PINK OWNER COPY (INITIAL): GOLD