* PERMIT REPLACES ONE ISSUED 8-9-04, NOW VOID

IREDELL COUNTY HEALTH DEPARTMENT

STATESVILLE 704-878-5305 MOORESVILLE 704-664-5281

IMPROVEMENT PERMIT / AUTHORIZATION TO CONSTRUCT / OPERATION PERMIT / EXISTING SYSTEM INSPECTION

PERMIT# 123094 PIN# 4851-36-3095 DATE 9-23-04

OWNER OR CONTRACTOR LORETTA DEVORE PHONE: Business (704) 539-5102 Home (704) 924-5146

ADDRESS 868 UNION GROVE RD, UNION GROVE NC 28689

LOCATION I-77N EXIT 59 TR TOMLIN MILL RD TL JOSEY TR OLIN TR SLOANS MILL PROP ON CORNER OF COWDEN FORD

SUBDIVISION _____ BLOCK / SECTION _____ LOT _____ LOT AREA _____ SITE CLASS. PS DESIGN FLOW 360 L.T.A.R. 0.3 GPD/FT²

Septic Tank: 1000 Gallons; STB 160 Date 7-28-04
Pump Tank: _____ Gallons; PT _____ Date _____
Pump Make: _____ Model _____ Serial No. _____
Nitrification Field: No Fields 1 Square Feet 1200 Linear Feet 300
No Lines 3 Trench Width 36" Max Trench Bottom Depth 36" Gravel Depth N/A

☑ New System ☐ Repair System Type: I, II, III, IV, V, VI
System Description: GRAVITY 25% REDUCTION
Repair System Description: LP PANEL 50% RED.
Maintenance Agreement Required: ☐ Yes ☑ No

☐ House/Mod. Home No. Bedrooms 3
☑ Mobile Home No. Bathrooms _____
☐ Business No. Employees _____
☐ Other _____
☐ Slab ☑ Crawl Space ☐ Basement w/plumbing ☐ Basement wo/plumbing


Water Supply: ☐ Individual ☑ Public ☐ Community IREDELL WATER

Comments/Conditions: ① INSTALL LINES 36" ON CONTOUR ② PUMP, CRUSH, FILL OLD TANK ③ PLUMBING ELEVATION CRITICAL OR MAY HAVE TO PUMP ④ NEED TO REMOVE LARGE WEEPING WILLOW TREE, ET AL


Comments/Conditions: ⑤ OLD MOBILE HOME MUST BE REMOVED FROM PROPERTY * ⑥ THE ORIGINAL 30-DAY NOV EXPIRED 9-9-04, THIS PERMIT SERVES AS AN ADDITIONAL 5-DAY NOV FOR CORRECTING THE SITUATION

* SCALE 1" = 50'

INITIAL SITE SKETCH

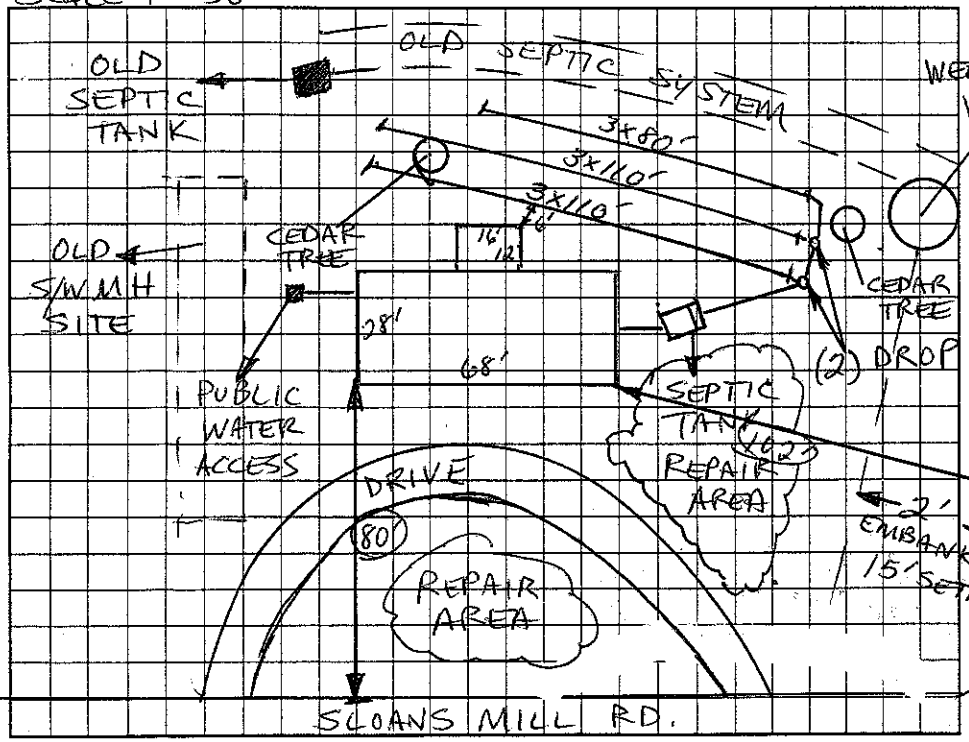

AS BUILT SKETCH

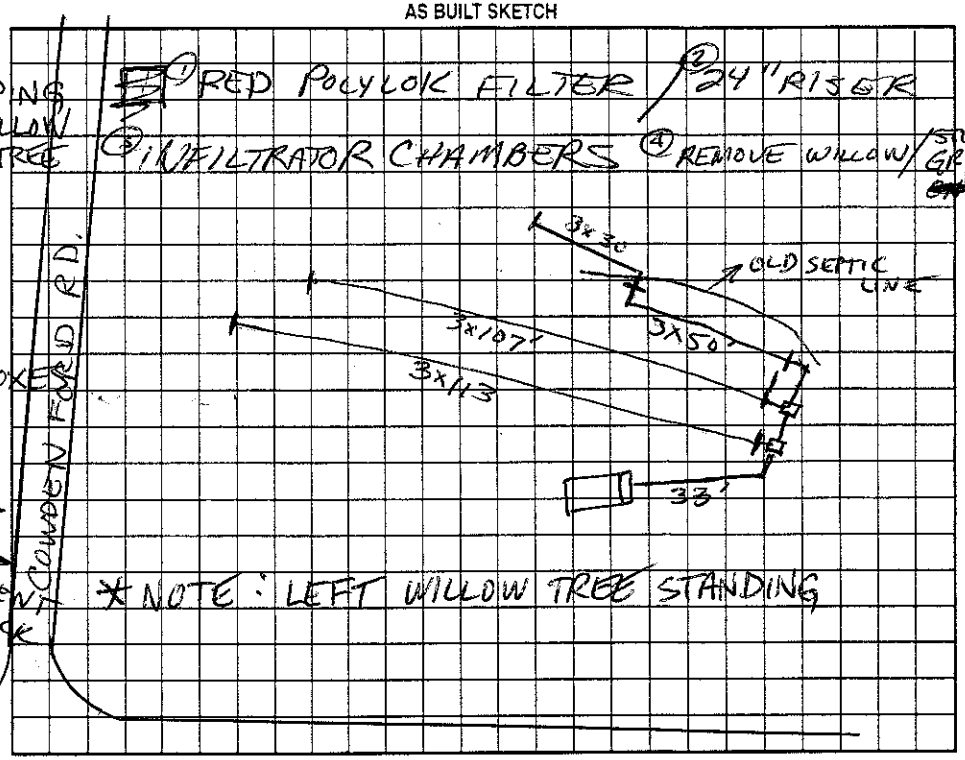

Permit can be suspended or revoked if any false information is supplied toward securing the permit/any unauthorized changes are made to the site/any unauthorized changes are made in the installation of the system. Improvement Permit with plat valid without expiration. Improvement Permit with site plan valid for sixty months. Authorization to Construct is valid for a period equal to that of Improvement Permit – not to exceed sixty months.

Signed: Loretta A. DeVore date 9-24-04 Installed by: EARTH MOVERS

Improvement Permit by: Christopher M. Shuffler, LHS date 9-23-04 Operation Permit by: Christopher M. Shuffler, LHS date _____

Authorization to Construct by: Christopher M. Shuffler, LHS date 9-23-04 Existing System Inspection by: _____ date _____

HEALTH DEPT. COPY: WHITE OWNER COPY (FINAL): YELLOW OWNER COPY (INITIAL): PINK