IREDELL COUNTY HEALTH DEPARTMENT - *ENVIRONMENTAL HEALTH* ☒ STATESVILLE OFFICE 704-878-5305 ☐ MOORESVILLE OFFICE 704-664-5281

IMPROVEMENT PERMIT / AUTHORIZATION TO CONSTRUCT / OPERATION PERMIT / EXISTING SYSTEM INSPECTION

PERMIT # 175699 PIN # 4851385492 DATE 11/6/12

OWNER John M Hunt APPLICANT: PHONE: Home/Cell # 8283204644 Business #

SITE ADDRESS 570 Sloans Mill Rd OWNER / APPLICANT ADDRESS

SITE DIRECTIONS 77N, (L) on Memorial Hwy, (L) on Pioneer Rd, (2) Sloan's Mill Rd

SUBDIVISION n/a BLOCK / SECTION n/a LOT # n/a LOT AREA 1 Ac DESIGN FLOW 240 L.T.A.R. Ex.

Septic Tank Ex. (1000) Gallons: STB Date

Pump Tank Gallons: P T Date

Pump Make Model Serial #

No. Nitrification Fields: 1 No. Lines Ex. (2) Linear Feet Ex. (240)

Trench Width Ex Max. Trench Bottom Depth Ex Gravel Depth Ex

☐ New System ☐ Repair ☐ Expansion System Type I II III IV V VI

System Description: Existing

Repair System Description:

Maintenance Agreement Required ☐ YES ☐ NO

☒ GRAVITY ☐ PRESSURE

☐ Residence No. Bedrooms

☐ Business No. Persons

☐ Other No. Employees

☐ Slab ☒ Crawl Space

☐ Basement w/plumbing ☐ Basement w/o plumbing

Water Supply


☐ Private

☐ Public.


☒ Community

Comments / Conditions

INITIAL SITE SKETCH

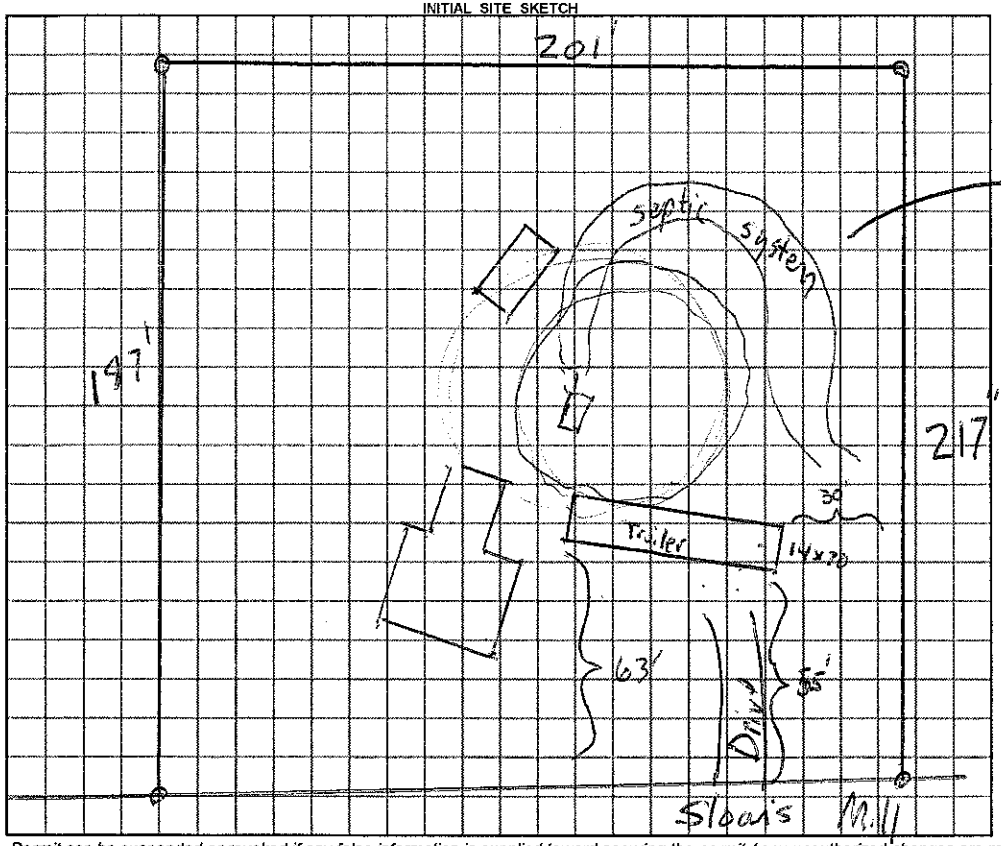

AS BUILT SKETCH

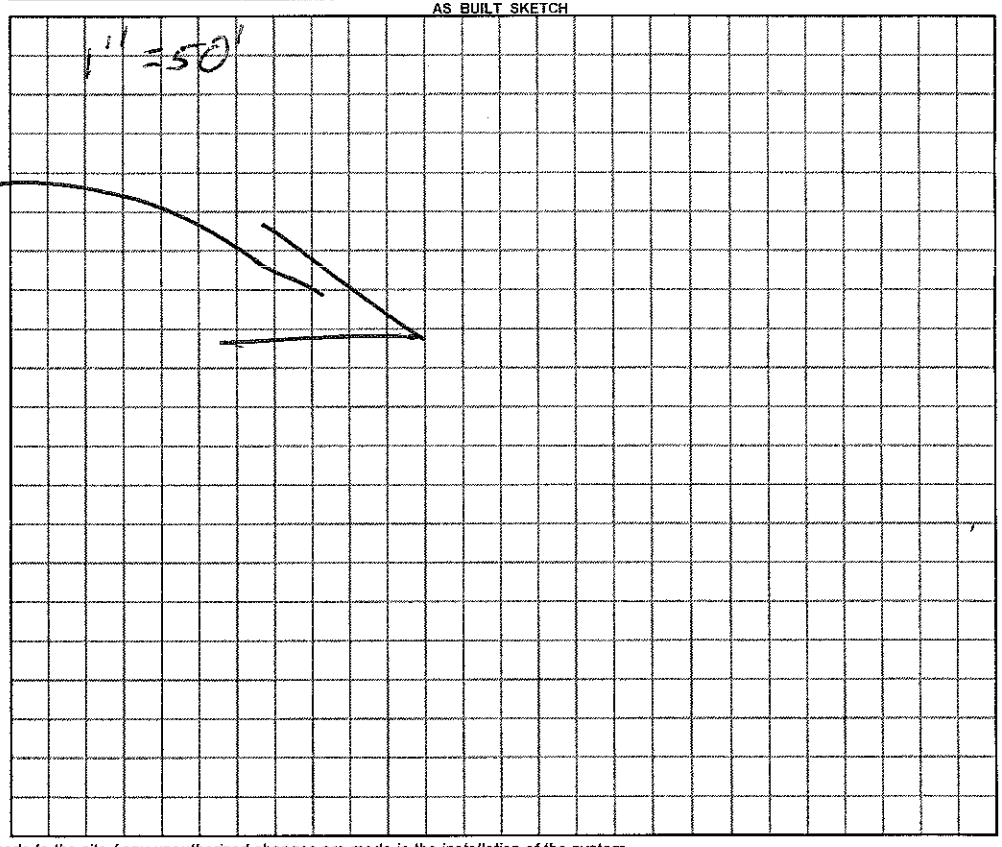

Permit can be suspended or revoked if any false information is supplied toward securing the permit / any unauthorized changes are made to the site / any unauthorized changes are made in the installation of the system.

☐ ***IMPROVEMENT PERMIT*** *with plat valid without expiration.* ☐ ***IMPROVEMENT PERMIT*** *with plat ~~valid without expiration~~ site plan valid 60 mo.* ☐ ***AUTHORIZATION TO CONSTRUCT*** valid for period equal to IMPROVEMENT PERMIT--not to exceed 60 mo.

Owner / Applicant Signature: Date Installed by:

IMPROVEMENT PERMIT by: ***REHS*** Date OPERATION PERMIT by: ***REHS*** Date

AUTHORIZATION TO CONSTRUCT by: ***REHS*** Date Existing System Inspected by: ***REHS*** Date 11-6-12

YOU SHOULD CONTACT A LOCATOR SERVICE PRIOR TO ANY EXCAVATION

White Copy – Environmental Health YELLOW COPY (Final) Owner / Applicant PINK COPY (Initial) Owner / Applicant