IREDELL COUNTY HEALTH DEPARTMENT

STATESVILLE 704-878-5305 MOORESVILLE 704-664-5281

IMPROVEMENT PERMIT / AUTHORIZATION TO CONSTRUCT / OPERATION PERMIT / EXISTING SYSTEM INSPECTION

PERMIT# REPAIR PIN# 4851 39 3448 DATE 5-16-03

OWNER OR CONTRACTOR PAULA MC CONNELL PHONE: Business 704-924-8870 Home 704-872-8898

ADDRESS 129 SPRINGFIELD ROAD, STATESVILLE NC 28677

LOCATION US 21 N, TL JENNINGS RD, TR OLIN LOOP RD (NORTH), TL SLOANS MILL ROAD, ON RIGHT AT #629

SUBDIVISION _____ BLOCK / SECTION _____ LOT _____ LOT AREA 6.29 ACRES SITE CLASS PS DESIGN FLOW 360 L.T.A.R. EXISTING

Septic Tank: EXISTING Gallons; STB _____ Date _____

Pump Tank: _____ Gallons; PT _____ Date _____

Pump Make: _____ Model _____ Serial No. _____

Nitrification Field: No Fields 1 Square Feet 630 Linear Feet 210

No Lines THREE Trench Width 36" Max Trench Bottom Depth 36" Gravel Depth 18"

☐ New System ☑ Repair System Type: I (II) III, IV, V, VI

System Description: _____

Repair System Description: CONVENTIONAL GRAVITY

Maintenance Agreement Required: ☐ Yes ☐ No

☑ House/Mod. Home No. Bedrooms 3

☐ Mobile Home No. Bathrooms 1

☐ Business No. Employees _____

☐ Other _____


☐ Slab ☑ Crawl Space ☐ Basement w/plumbing ☐ Basement wo/plumbing

Water Supply: ☑ Individual ☐ Public ☐ Community WELL

Comments:/Conditions: ① INSTALL NEW DRAINLINES AS SHOWN USING 18" STONE ② INSTALL NEW SANITARY TEE IN SEPTIC TANK - REPLACE SEPTIC TANK IF NECESSARY

Comments:/Conditions:

INITIAL SITE SKETCH

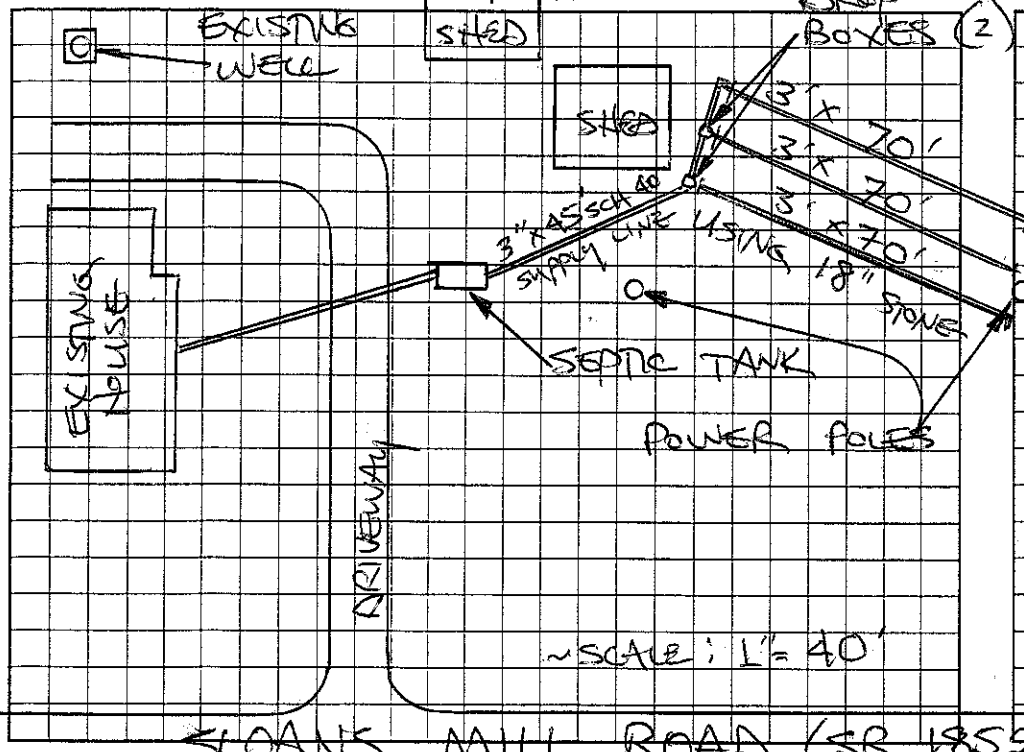

AS BUILT SKETCH

SYSTEM REPAIRED ACCORDING TO INITIAL SITE SKETCH

Permit can be suspended or revoked if any false information is supplied toward securing the permit/any unauthorized changes are made to the site/any unauthorized changes are made in the installation of the system. Improvement Permit with plat valid without expiration. Improvement Permit with site plan valid for sixty months. Authorization to Construct is valid for a period equal to that of Improvement Permit – not to exceed sixty months.

Signed: X Thomas J. Davis date 5-15-03 Installed by: A-1 BACKHOE

Improvement Permit by: STEVE HEDRICK date 5-16-03 Operation Permit by: STEVE HEDRICK date 6-5-03

Authorization to Construct by: STEVE HEDRICK date 5-16-03 Existing System Inspection by: _____ date _____

HEALTH DEPT. COPY: WHITE OWNER COPY (FINAL): YELLOW OWNER COPY (INITIAL): PINK