IREDELL COUNTY HEALTH DEPARTMENT

STATESVILLE 704-878-5305 MOORESVILLE 704-664-5281

IMPROVEMENT PERMIT / AUTHORIZATION TO CONSTRUCT / OPERATION PERMIT / EXISTING SYSTEM INSPECTION

PERMIT# 103908 PIN# 4851-49-3490 DATE 1-9-02

OWNER OR CONTRACTOR LINDA CAMPBELL PHONE: Business Home (704) 539-5329

ADDRESS 161 PRIDE LANE, OLIN NC 28660

LOCATION I-77N, TL NC 901, TL SLOANS MILL RD, TL PRIDE LANE, 1ST MH GRD ON LEFT

SUBDIVISION BLOCK / SECTION LOT LOT AREA ~1 ACRE SITE CLASS PS DESIGN FLOW 360 L.T.A.R. 0.30 GAD/FT²

Septic Tank: 1000 Gallons: STB 1012 Date 11-6-01
Pump Tank: Gallons: PT Date
Pump Make: Model Serial No.
Nitrification Field: No Fields 1 Square Feet 1200 Linear Feet 400
No Lines FOUR Trench Width 36" Max Trench Bottom Depth 30"

☑ New System ☐ Repair System Type: I II III IV V VI
System Description: CONVENTIONAL GRAVITY
Repair System Description: 50% REDUCTION GRAVITY
Maintenance Agreement Required: ☐ Yes ☑ No
☐ Slab ☑ Crawl Space ☐ Basement w/plumbing ☐ Basement wo/plumbing


☐ House/Mod. Home No. Bedrooms 3
☑ Mobile Home No. Bathrooms 2
☐ Business No. Employees
☐ Other

Water Supply:
☑ Individual
☐ Public
☐ Community
WELL NEXT DOOR

Comments/Conditions: ① REMOVE EXISTING FIELD TERRACE
② KEEP SYSTEM MINIMUM TEN FEET FROM PROPOSED PROPERTY LINES

Comments/Conditions: SEPTIC TANK WITH MARKER INSTALLED USING "POLY/LOK" FILTER

INITIAL SITE SKETCH

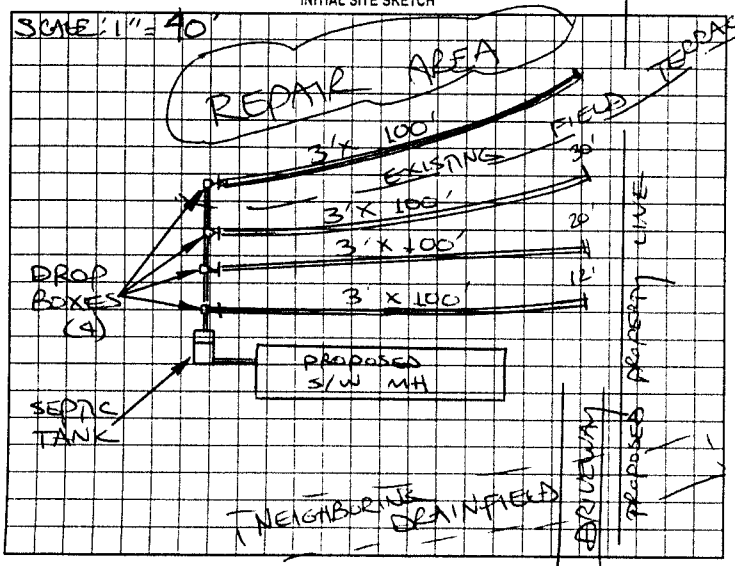

AS BUILT SKETCH

SYSTEM INSTALLED ACCORDING TO INITAL SITE SKETCH

Permit can be suspended or revoked if any false information is supplied toward securing the permit/any unauthorized changes are made to the site/any unauthorized changes are made in the installation of the system. Improvement Permit with plat valid without expiration. Improvement Permit with site plan valid for sixty months. Authorization to Construct is valid for a period equal to that of Improvement Permit – not to exceed sixty months.

Signed: "Easy for Compliance" date 1-9-02 Installed by: DALE WILLIAMS

Improvement Permit by: STEVE HEDRICK date 1-9-02 Operation Permit by STEVE HEDRICK date 2-1-02

Authorization to Construct by: STEVE HEDRICK date 1-9-02 Existing System Inspection by: date

HEALTH DEPT. COPY WHITE OWNER COPY (FINAL) YELLOW OWNER COPY (INITIAL) PINK