# IREDELL COUNTY HEALTH DEPARTMENT

STATESVILLE 704-878-5305 MOORESVILLE 704-664-5281

## IMPROVEMENT PERMIT / AUTHORIZATION TO CONSTRUCT / OPERATION PERMIT / EXISTING SYSTEM INSPECTION

PERMIT# 105218 PIN# 4857-88-2906 DATE 3-18-02

OWNER OR CONTRACTOR DONNIE B COOK PHONE: Business _____ Home 704-500-6362

ADDRESS 157 ELLIS ROAD STATESVILLE NC 28625

LOCATION I-77 N, TR NC 901, TR JERICHO RD, TL DAMRON LANE, 1ST LOT ON LEFT

SUBDIVISION JERICHO RIDGE BLOCK / SECTION I LOT 20 LOT AREA 0.96 ACRE SITE CLASS PS DESIGN FLOW 360 L.T.A.R. 0.30 GPD/FT²

Septic Tank: 1000 Gallons: STB _____ Date _____

Pump Tank: _____ Gallons: PT _____ Date _____

Pump Make: _____ Model _____ Serial No _____

Nitrification Field: No Fields 1 Square Feet 672.70 / 200 Linear Feet 200

No Lines FIVE Trench Width 24" Max Trench Bottom Depth 30"

☐ New System ☐ Repair System Type: I II III IV V VI

System Description: PRBPS, GRAVITY

Repair System Description: 50% REDUCTION, LOW PRESS

Maintenance Agreement Required: ☐ Yes ☐ No

Gravel Depth 6" (SAND) ☐ Slab ☐ Crawl Space ☐ Basement w/plumbing ☐ Basement wo/plumbing

☐ House/Mod. Home No. Bedrooms 2

☐ Mobile Home No. Bathrooms 1

☐ Business No. Employees _____


☐ Other _____

Water Supply: ☐ Individual ☐ Public ☐ Community


Comments/Conditions:

Comments/Conditions: KEEP MH MINIMUM 5' FROM SYSTEM

INITIAL SITE SKETCH

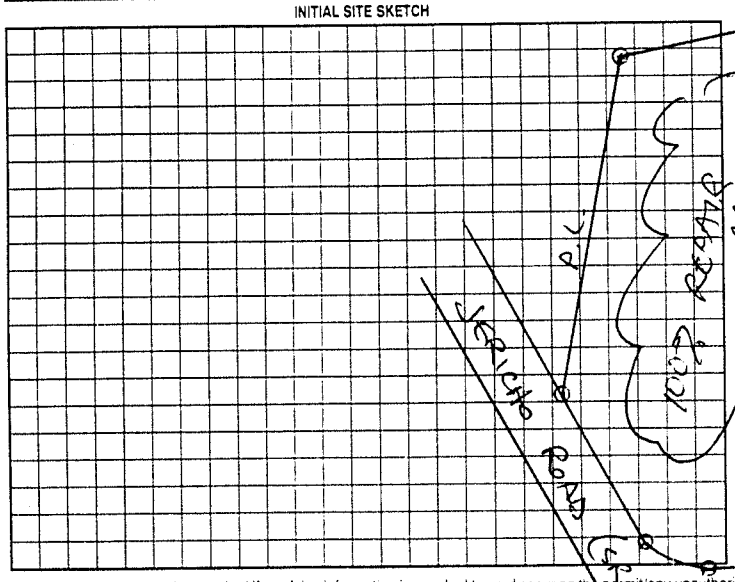


AS BUILT SKETCH SCALE: 1"=40'

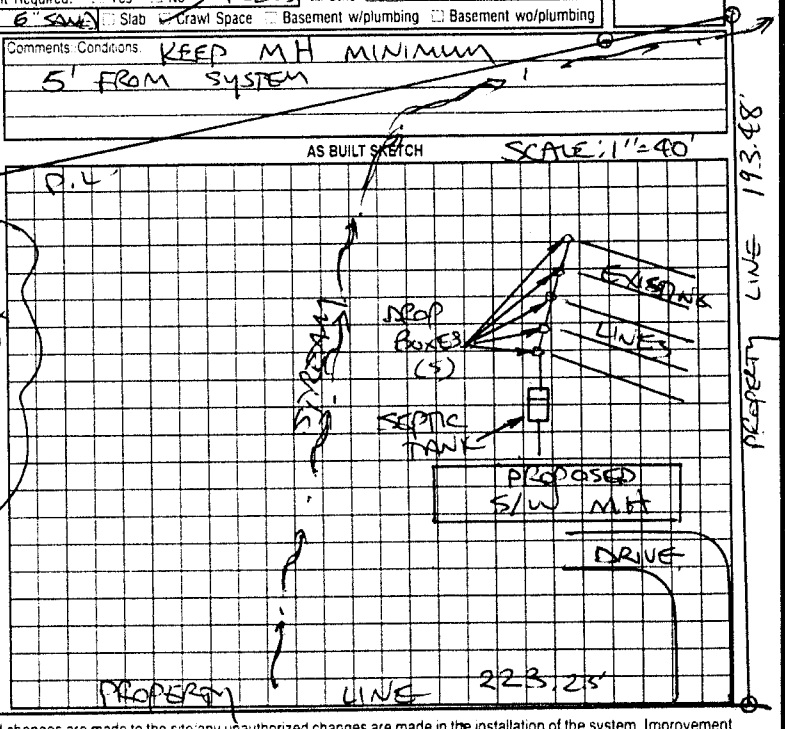


Permit can be suspended or revoked if any false information is supplied toward securing the permit, any unauthorized changes are made to the site, any unauthorized changes are made in the installation of the system. Improvement Permit with plat valid without expiration. Improvement Permit with site plan valid for sixty months. Authorization to Construct is valid for a period equal to that of Improvement Permit, not to exceed sixty months.

Signed: _____ date _____

Improvement Permit by: _____ date _____

Authorization to Construct by: _____ date _____

Installed by: _____

Operation Permit by: _____ date _____

Existing System Inspection by: STEVE HENDRICK date 3-18-02

HEALTH DEPT. COPY WHITE OWNER COPY (FINAL) YELLOW OWNER COPY (INITIAL) PINK