IREDELL COUNTY HEALTH DEPARTMENT

STATESVILLE 704-878-5305 MOORESVILLE 704-664-5281

IMPROVEMENT PERMIT / AUTHORIZATION TO CONSTRUCT / OPERATION PERMIT / EXISTING SYSTEM INSPECTION

PERMIT# 116006 PIN# 4851-88-2906.020 DATE 10-2-03

OWNER OR CONTRACTOR JAMES R. HADEN PHONE: Business 704-872-0227 Home 704-838-1365

ADDRESS 349 GILBERT ROAD, STATESVILLE, NC 28677

LOCATION I-77 N, TR NC901, TR JERICHO ROAD, TL DAMRON LANE 1ST LOT ON LEFT

SUBDIVISION JERICHO RIDGE BLOCK / SECTION I LOT 20 LOT AREA 0.96 ACS SITE CLASS. PS ? DESIGN FLOW 360 L.T.A.R. 0.30 GPD/FT2

Septic Tank: 1000 Gallons; STB ____ Date ____

Pump Tank: ____ Gallons; PT ____ Date ____

Pump Make: ____ Model ____ Serial No. ____

Nitrification Field: No Fields 1 Square Feet EQ.P/200 Linear Feet 200

No Lines FIVE Trench Width 24" Max Trench Bottom Depth 36" Gravel Depth SAND

☐ New System ☐ Repair System Type: I, II, (III), IV, V, VI

System Description: 30% REDUCTION GRAVITY

Repair System Description: 50% REDUCTION LOW PRESSURE

Maintenance Agreement Required: ☐ Yes ☐ No

☐ House/Mod. Home ☑ Mobile Home ☐ Business ☐ Other

No. Bedrooms 3 No. Bathrooms 2 No. Employees ____


☐ Slab ☑ Crawl Space ☐ Basement w/plumbing ☐ Basement wo/plumbing

Water Supply: ☐ Individual ☑ Public ☐ Community


Comments:/Conditions:

Comments:/Conditions:

INITIAL SITE SKETCH

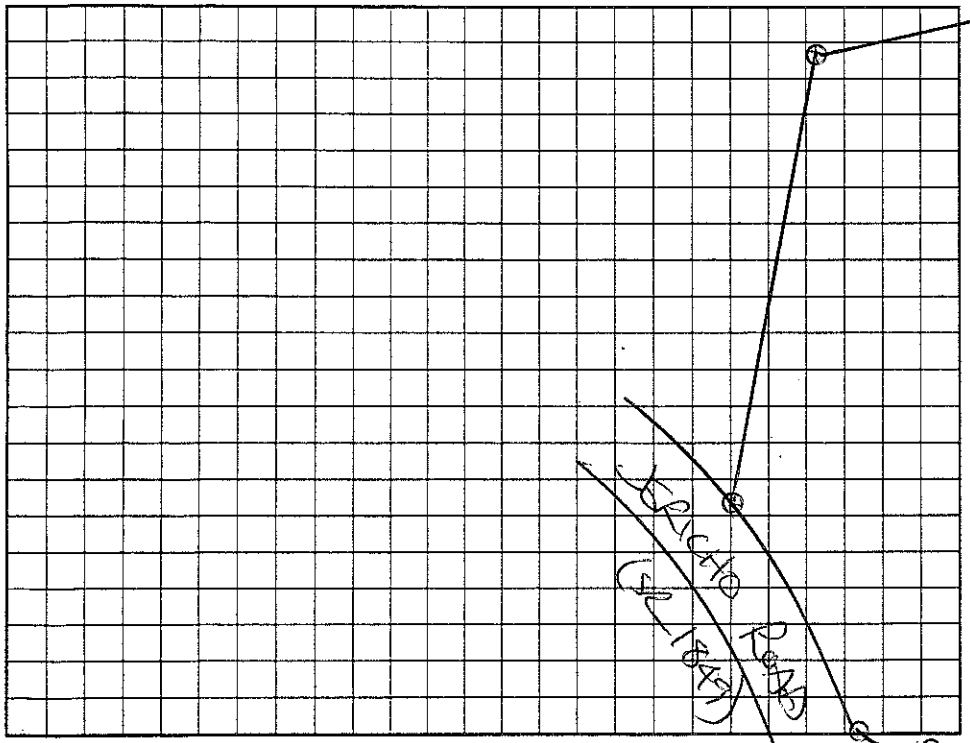

AS BUILT SKETCH

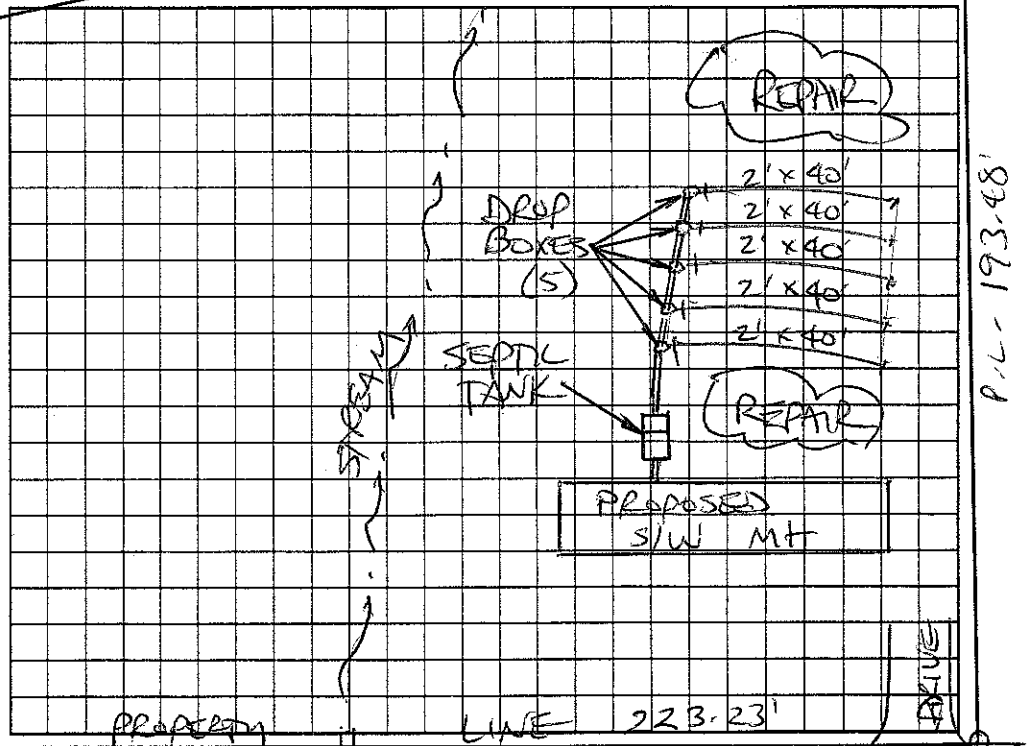

Permit can be suspended or revoked if any false information is supplied toward securing the permit/any unauthorized changes are made to the site/any unauthorized changes are made in the installation of the system. Improvement Permit with plat valid without expiration. Improvement Permit with site plan valid for sixty months. Authorization to Construct is valid for a period equivalent to that of Improvement Permit – not to exceed sixty months.

Signed: ____ date ____ Installed by: ____

Improvement Permit by: ____ date ____ Operation Permit by: ____ date ____

Authorization to Construct by: ____ date ____ Existing System Inspection by: STEVE HEDRICK date 10-2-03

HEALTH DEPT. COPY: WHITE OWNER COPY (FINAL): YELLOW OWNER COPY (INITIAL): PINK