IREDELL COUNTY HEALTH DEPARTMENT

STATESVILLE 704-878-5305 MOORESVILLE 704-664-5281

IMPROVEMENT PERMIT / AUTHORIZATION TO CONSTRUCT / OPERATION PERMIT / EXISTING SYSTEM INSPECTION

PERMIT# 90132 PIN# 4851886809 DATE 7/18/00

OWNER OR CONTRACTOR BOB HARDEN PHONE: Business 872-0227 Home

ADDRESS 246 JERICHO RD

LOCATION 901- TR JERICHO RD. 2nd PAST BR DAMEON ON LT

SUBDIVISION JERICHO RIDGE BLOCK / SECTION 1 LOT 13 LOT AREA .86AC SITE CLASS PS DESIGN FLOW 360GPD L.T.A.R. .3gpd/ft²

Septic Tank: 1000 Gallons; STB 512 Date 7/7/00
Pump Tank: Gallons; PT Date
Pump Make: Model Serial No.
Nitrification Field: No Fields 1 Square Feet 900 Linear Feet 300
No Lines 3@100' Trench Width 36" Max Trench Bottom Depth 36" Gravel Depth N/A

☑ New System ☐ Repair System Type: I, II, III, IV, V, VI
System Description: GRAVITY 25% REDUCTION
Repair System Description: GRAVITY PANEL
Maintenance Agreement Required: ☐ Yes ☑ No

☐ House/Mod. Home ☑ Mobile Home ☐ Business ☐ Other
No. Bedrooms 3 No. Bathrooms 2 No. Employees


☐ Slab ☑ Crawl Space ☐ Basement w/plumbing ☐ Basement wo/plumbing

Water Supply: ☐ Individual ☑ Public ☐ Community


Comments/Conditions:

Comments/Conditions: (LOT 13 & 14 COMBINED)

INITIAL SITE SKETCH 1"=50'

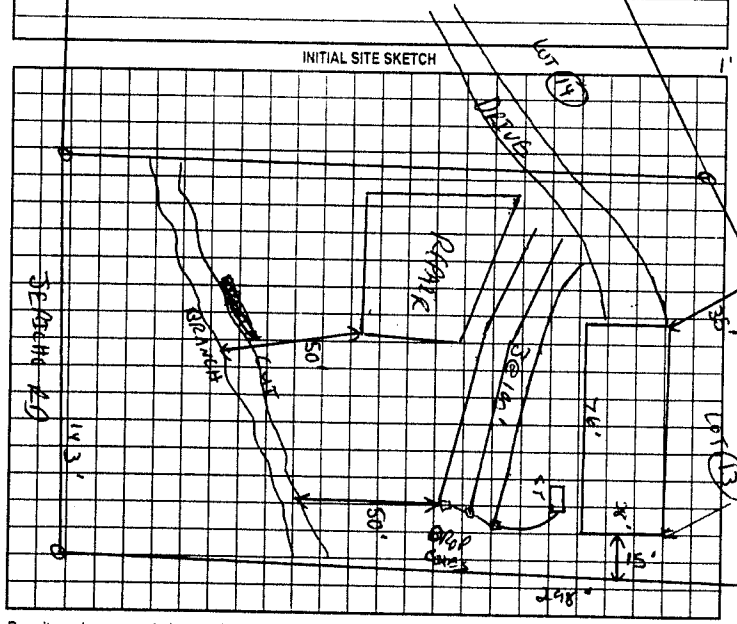

AS BUILT SKETCH

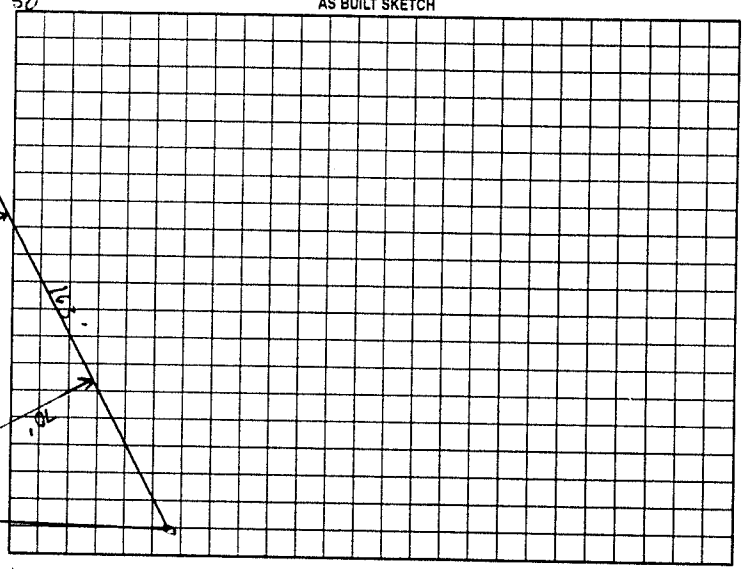

Permit can be suspended or revoked if any false information is supplied toward securing the permit/any unauthorized changes are made to the site/any unauthorized changes are made in the installation of the system. Improvement Permit with plat valid without expiration. Improvement Permit with site plan valid for sixty months. Authorization to Construct is valid for a period equal to that of Improvement Permit – not to exceed sixty months.

Signed: Michael E. Ley date 7.24.00 Installed by: Craig Thompson

Improvement Permit by: AS date 7/18/00 Operation Permit by: date 8/11/00

Authorization to Construct by: AS date 7/18/00 Existing System Inspection by: date

HEALTH DEPT. COPY: WHITE OWNER COPY (FINAL): YELLOW OWNER COPY (INITIAL): PINK