IREDELL COUNTY HEALTH DEPARTMENT

STATESVILLE 704-878-5305 MOORESVILLE 704-664-5281

IMPROVEMENT PERMIT / AUTHORIZATION TO CONSTRUCT / OPERATION PERMIT / EXISTING SYSTEM INSPECTION

PERMIT# 11513 PIN# 4851-82-9400 DATE 9-20-03

OWNER OR CONTRACTOR FLEETWOOD HOMES OF STATESVILLE PHONE: Business 704-400-7019 Home

ADDRESS 1270 NORTHSIDE DR STATESVILLE NC 28677

LOCATION 77 NORTH @ 901, @ TURN'D PAST SHARP CURVE ON RT ON TOP OF HILL

SUBDIVISION BLOCK / SECTION LOT LOT AREA 1.0 AC SITE CLASS. DESIGN FLOW 360 L.T.A.R. EXISTING

Septic Tank: Gallons; STB Date

Pump Tank: Gallons; PT Date

Pump Make: Model Serial No.

Nitrification Field: No Fields 1 Square Feet Linear Feet ≈230

No Lines 3 Trench Width Max Trench Bottom Depth Gravel Depth

☐ New System ☐ Repair System Type: I, II, III, IV, V, VI

System Description: GRAV (CONV) TERRACOTA

Repair System Description: LP PANEL

Maintenance Agreement Required: ☒ Yes ☐ No

☐ House/Mod. Home No. Bedrooms 3

☒ Mobile Home D/W No. Bathrooms 2

☐ Business No. Employees


☐ Other

☐ Slab ☒ Crawl Space ☐ Basement w/plumbing ☐ Basement wo/plumbing

Water Supply: ☒ Individual ☐ Public ☐ Community WELL

Comments/Conditions: ① NO OLD PERMIT FOUND FOR EXISTING SYSTEM CHECK ② PROBED OUT 230 OF LINE AS DRAWN ③ APPLICANT SIGNED APPLICATION STATING PREVIOUS HOME WAS A 3 BEDROOM & REPLACING WITH A 3 BEDROOM ④ MAINTAIN SETBACKS ⑤ HOUSE/D/W IS FLAGGED 100' OFF ROAD

"NOT TO SCALE" INITIAL SITE SKETCH

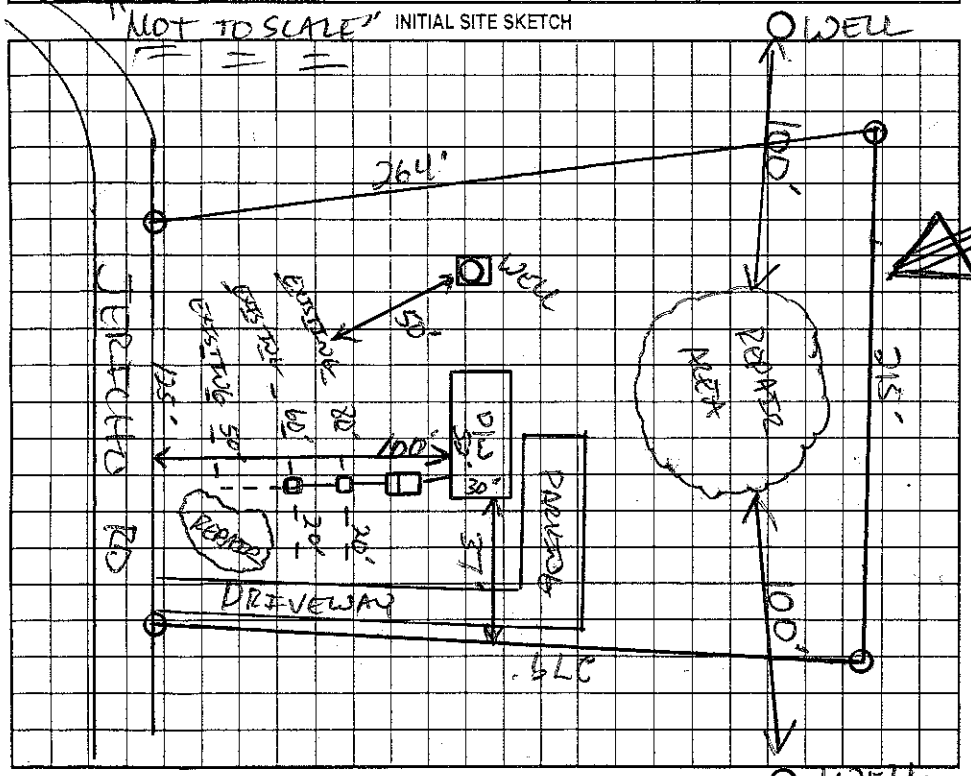

AS BUILT SKETCH

Permit can be suspended or revoked if any false information is supplied toward securing the permit/any unauthorized changes are made to the site/any unauthorized changes are made in the installation of the system. Improvement Permit with plat valid without expiration. Improvement Permit with site plan valid for sixty months. Authorization to Construct is valid for a period equal to that of Improvement Permit – not to exceed sixty months.

Signed: date 9/22/03 Installed by:

Improvement Permit by: date Operation Permit by: date

Authorization to Construct by: date Existing System Inspection by: date 9-20-03

HEALTH DEPT. COPY: WHITE OWNER COPY (FINAL): YELLOW OWNER COPY (INITIAL): PINK