THIS PERMIT VOIDS PREVIOUS ISSUED 4-9-98

IREDELL COUNTY HEALTH DEPARTMENT

STATESVILLE 704-878-5305 MOORESVILLE 704-664-5281

IMPROVEMENT PERMIT / AUTHORIZATION TO CONSTRUCT / OPERATION PERMIT / EXISTING SYSTEM INSPECTION

PERMIT# 072371 PIN# 4851 87 3804 (PT) DATE 5-12-2000

OWNER OR CONTRACTOR JAMES KING PHONE: Business c/o 873-2547 Home

ADDRESS c/o P.O. BOX 1651 STATESVILLE NC 28687

LOCATION I-77 N, TR NC 901, TR JERICHO ROAD, TL DAMRON LANE, 2ND LOT ON LEFT

SUBDIVISION JERICHO RIDGE BLOCK / SECTION LOT 19 LOT AREA 0.79 ACRE SITE CLASS PS DESIGN FLOW 240 L.T.A.R. 0.30 GPD/FT²

Septic Tank: 1000 Gallons; STB 1012 Date 2-13-00
Pump Tank: Gallons; PT Date
Pump Make: Model Serial No.
Nitrification Field: No Fields 1 Square Feet 810 Linear Feet 270
No Lines FOUR Trench Width 36" Max Trench Bottom Depth 30" Gravel Depth 12"

☑ New System ☐ Repair System Type: I II III IV V VI
System Description: CONVENTIONAL GRAVITY
Repair System Description: CONV. GRAVITY
Maintenance Agreement Required: ☐ Yes ☑ No


☐ House/Mod. Home No. Bedrooms 2
☑ Mobile Home No. Bathrooms 1
☐ Business No. Employees
☐ Other
☐ Slab ☑ Crawl Space ☐ Basement w/plumbing ☐ Basement wo/plumbing

Water Supply: ☐ Individual ☑ Public ☐ Community


Comments/Conditions: INSTALL SUBSURFACE INTERCEPT DRAINAGE DITCH AS SHOWN BEGINNING 42" DEEP OUT TO DAYLIGHT

Comments/Conditions:

INITIAL SITE SKETCH SCALE: 1" = 50'

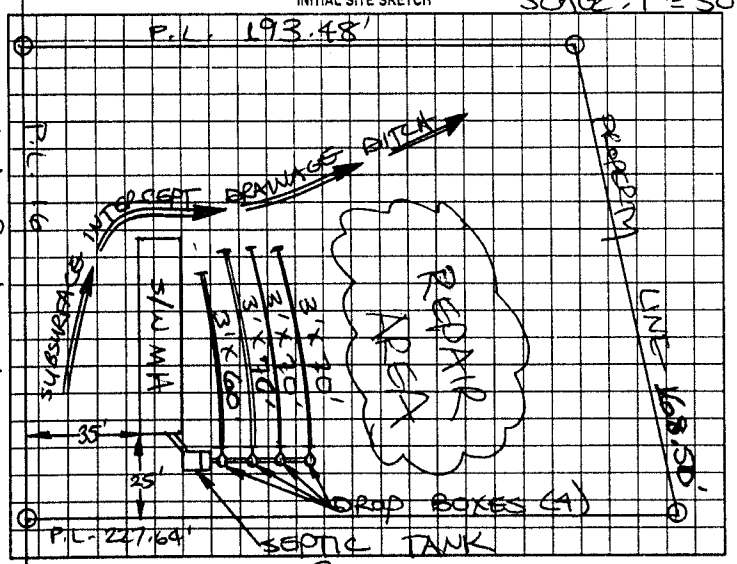

AS BUILT SKETCH

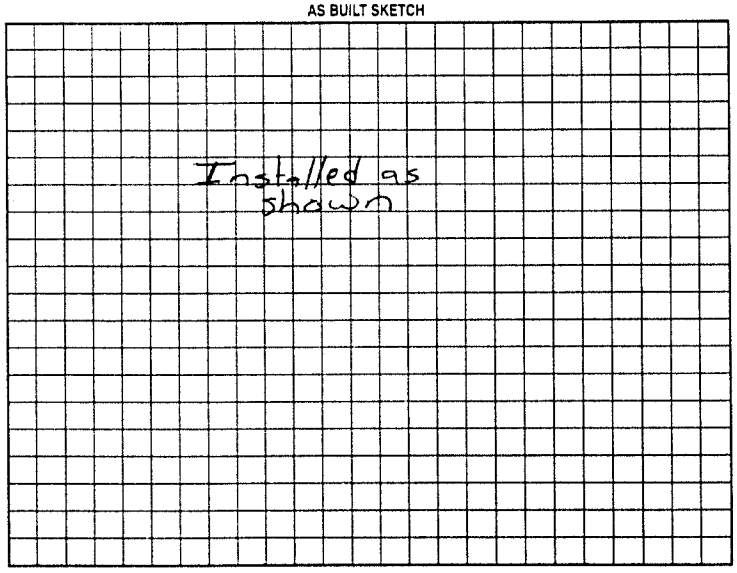

Permit can be suspended or revoked if any false information is supplied toward securing the permit/any unauthorized changes are made to the site/any unauthorized changes are made in the installation of the system. Improvement Permit with plat valid without expiration. Improvement Permit with site plan valid for sixty months. Authorization to Construct is valid for a period equal to that of Improvement Permit – not to exceed sixty months.

Signed: date 5-17-00 Installed by: A-1 Backhoe

Improvement Permit by: STEVE HEDRICK date 5-12-2000 Operation Permit by: Mat C.O.J. RS date 5-18-00

Authorization to Construct by: STEVE HEDRICK date 5-12-2000 Existing System Inspection by: date

HEALTH DEPT. COPY: WHITE OWNER COPY (FINAL) YELLOW OWNER COPY (INITIAL) PINK