IREDELL COUNTY HEALTH DEPARTMENT

STATESVILLE 704-878-5305 MOORESVILLE 704-664-5281

IMPROVEMENT PERMIT / AUTHORIZATION TO CONSTRUCT / OPERATION PERMIT / EXISTING SYSTEM INSPECTION

PERMIT# 092978 PIN# 4851 86 8132 DATE 11-29-00

OWNER OR CONTRACTOR JOHN YORK PHONE: Business 873-1189 Home 539-4611

ADDRESS 334 WILLIAMSBURG ROAD, OLIN NC 28660

LOCATION US 21 N, TL TABOR ROAD, TL WILLIAMSBURG ROAD, ON RIGHT AT BOX # 334, BACK OFF ROAD

SUBDIVISION _____ BLOCK / SECTION _____ LOT _____ LOT AREA 1.00 ACRE SITE CLASS. PS DESIGN FLOW 360 L.T.A.R. 0.30 GPD/FT²

Septic Tank: 1000 Gallons; STB 312 Date 2-2300
Pump Tank: _____ Gallons; PT _____ Date _____
Pump Make: _____ Model _____ Serial No. _____
Nitrification Field: No Fields 1 Square Feet 1200 Linear Feet _____
No. Lines FOUR Trench Width 36" Max Trench Bottom Depth (24") Gravel Depth 12"

☑ New System ☐ Repair System Type: I (II) III IV V VI
System Description: CONVENTIONAL GRAVITY
Repair System Description: CONV. GRAVITY
Maintenance Agreement Required: ☐ Yes ☑ No


☐ House/Mod. Home No. Bedrooms 3
☑ Mobile Home No. Bathrooms 2
☐ Business No. Employees _____
☐ Other _____
☐ Slab ☑ Crawl Space ☐ Basement w/plumbing ☐ Basement wo/plumbing

Water Supply: ☑ Individual ☐ Public ☐ Community
WELL NEXT DOOR


Comments/Conditions: ① KEEP SYSTEM MINIMUM 10 FEET FROM PROPERTY LINE ② INSTALL LINES ON CONTOUR AS FLAGGED, NO DEEPER THAN 24" DEEP.

Comments/Conditions: ① INSTALLED WITH TUFFLITE-FILTER ② INSTALLED AS SHOWN ③ INSTALLED WITH MARKER

INITIAL SITE SKETCH

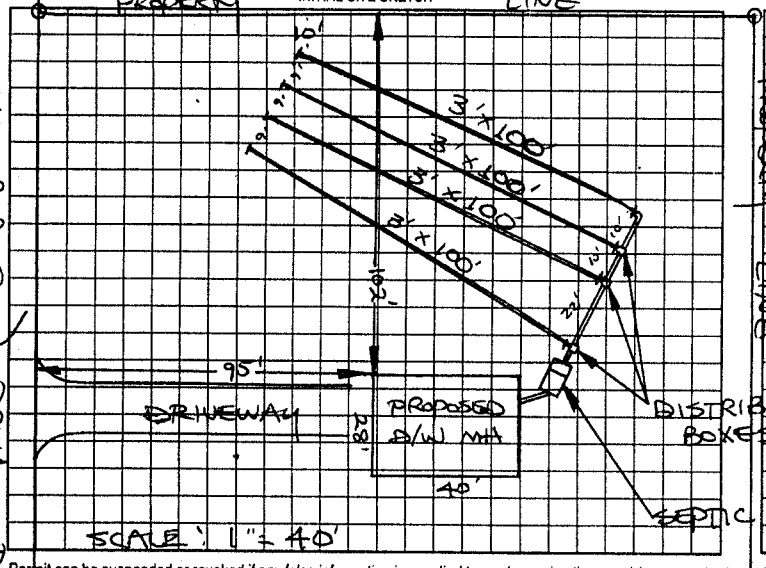

AS BUILT SKETCH

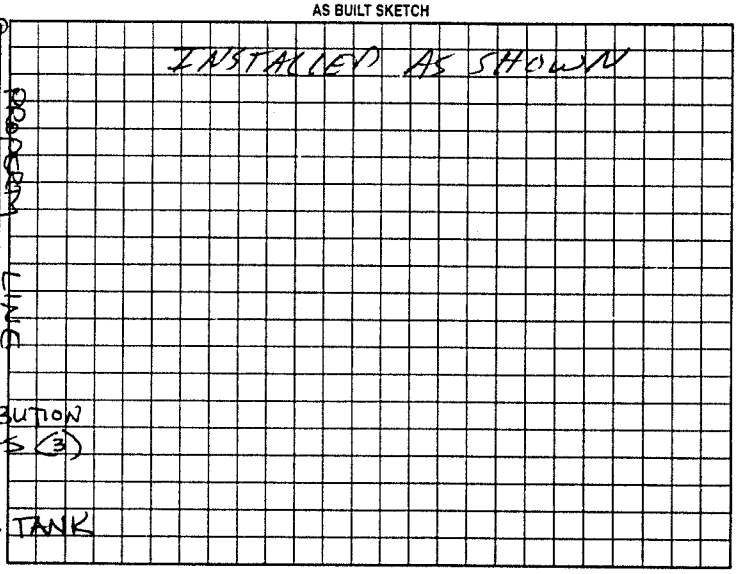

TO WILLIAMSBURG ROAD / PRIVATE DRIVE

Permit can be suspended or revoked if any false information is supplied toward securing the permit/any unauthorized changes are made to the site/any unauthorized changes are made in the installation of the system. Improvement Permit with plat valid without expiration. Improvement Permit with site plan valid for sixty months. Authorization to Construct is valid for a period equal to that of Improvement Permit – not to exceed sixty months.

Signed: X John Franklin York Jr date 11/29/00
Improvement Permit by: STEVE HEDRICK date 11-29-00
Authorization to Construct by: STEVE HEDRICK date 11-29-00

Installed by: Craig Thompson
Operation Permit by: [illegible] RSF date 02-01-01
Existing System Inspection by: _____ date _____

HEALTH DEPT. COPY: WHITE OWNER COPY (FINAL): YELLOW OWNER COPY (INITIAL): PINK