IREDELL COUNTY HEALTH DEPARTMENT

STATESVILLE 704-878-5305 MOORESVILLE 704-664-5281

IMPROVEMENT PERMIT / AUTHORIZATION TO CONSTRUCT / OPERATION PERMIT / EXISTING SYSTEM INSPECTION

PERMIT# 125250 PIN# 4851-98-3828 DATE 12-15-04

OWNER OR CONTRACTOR FLEETWOOD HOMES OF STATESVILLE PHONE: Business (704) 872-0179 Home

ADDRESS 1270 NORTHSIDE DRIVE STATESVILLE NC 28677

LOCATION I-77N TR HWY 901 TR JERICHO @ 3.5 MI TR DAISY FIELD CIR ON LEFT.

SUBDIVISION JERICHO RIDGE BLOCK / SECTION 2 LOT 7 LOT AREA .72 SITE CLASS. PS DESIGN FLOW 360 L.T.A.R. 0.30 gpd/ft²

Septic Tank: 1000 Gallons; STB 760 Date 9-4-04
Pump Tank: Gallons; PT Date
Pump Make: Model Serial No.
Nitrification Field: No Fields 1 Square Feet 1200 Linear Feet 400
No Lines 5 Trench Width 36" Max Trench Bottom Depth 36" Gravel Depth 12"

☑ New System ☐ Repair System Type: I (1) III, IV, V, VI
System Description: CONVENTIONAL GRAVITY
Repair System Description: GRAVITY 25% REDUCTION
Maintenance Agreement Required: ☐ Yes ☑ No

☐ House/Mod. Home No. Bedrooms 3
☑ Mobile Home No. Bathrooms
☐ Business No. Employees
☐ Other
☐ Slab ☑ Crawl Space ☐ Basement w/plumbing ☐ Basement wo/plumbing


Water Supply: ☐ Individual ☑ Public ☐ Community

Comments:/Conditions: ① INSTALL ON CONTOUR
② MAINTAIN SETBACKS

Comments:/Conditions: (3) RED POLYLOK (2) #5 STONE
③

*1" = 40'

INITIAL SITE SKETCH

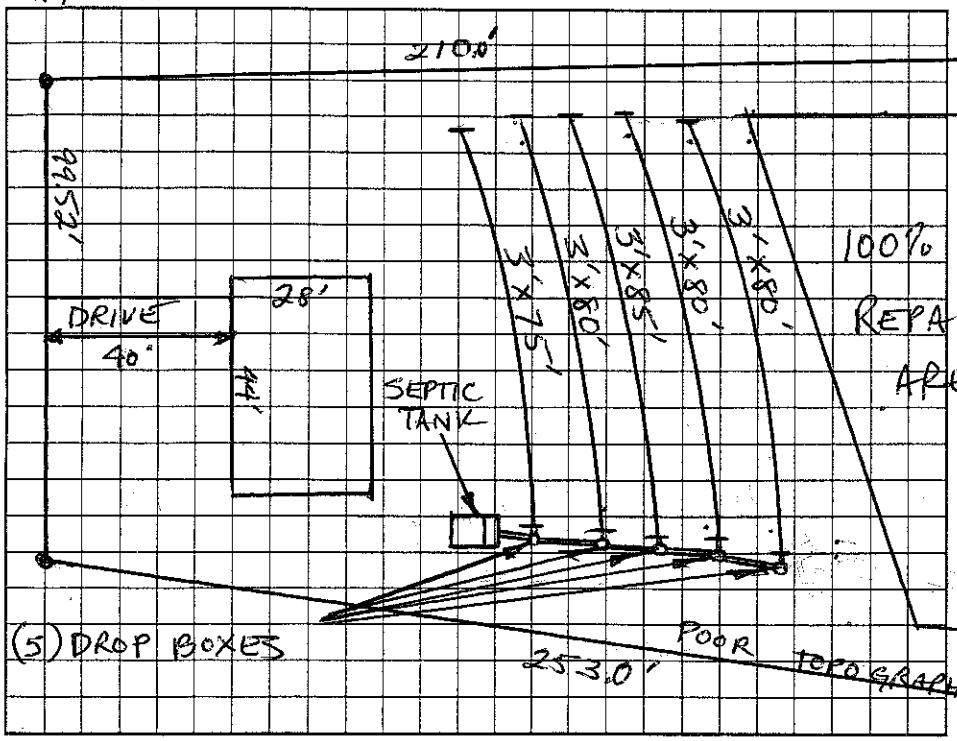

AS BUILT SKETCH

SYSTEM INSTALLED ACCORDING TO SKETCH

Permit can be suspended or revoked if any false information is supplied toward securing the permit/any unauthorized changes are made to the site/any unauthorized changes are made in the installation of the system. Improvement Permit with plat valid without expiration. Improvement Permit with site plan valid for sixty months. Authorization to Construct is valid for a period equal to that of Improvement Permit – not to exceed sixty months.

Signed: date 12/17/04 Installed by: TIM ABEE

Improvement Permit by: Christopher M. Sherrill LS date 12-15-04 Operation Permit by: Christopher M. Sherrill LS date 12-30-04

Authorization to Construct by: Christopher M. Sherrill LS date 12-15-04 Existing System Inspection by: date

HEALTH DEPT. COPY: WHITE OWNER COPY (FINAL): YELLOW OWNER COPY (INITIAL): PINK